

CS 39/171

ATTACHED ARE COPIES OF SELECT PAGES THAT REFER TO  
FD/SET GOVERNMENT CORNERS  
CS FILE CONTAINS MORE INFORMATION

Sec 18 - T305 - R5W

Fitz Patrick

April 1948

A.R. Evans A

M.E. Godfrey H.C.

L.E. Kerstner R.C.

Fitzpatrick Ave.

Eisenmann Ave.

D.B. Irving Locater

C.S. File No. 39/171

Sta Dist  $\pm$  C.C. M.C. Slope

Pt. ident  
fixed as  
 $\frac{1}{4}$  Cor  
by Epps.  
record.

~~1/4~~ -  $\frac{1}{4}$   
Cor  
(EPP.)  
AutoAxio

577<sup>R</sup>

18.

81° 5' R


00 01'  
0° 00' 30" R

589° 03' 30" E

589° 04' E

20°  
293  
+ 2

300  
+ 3

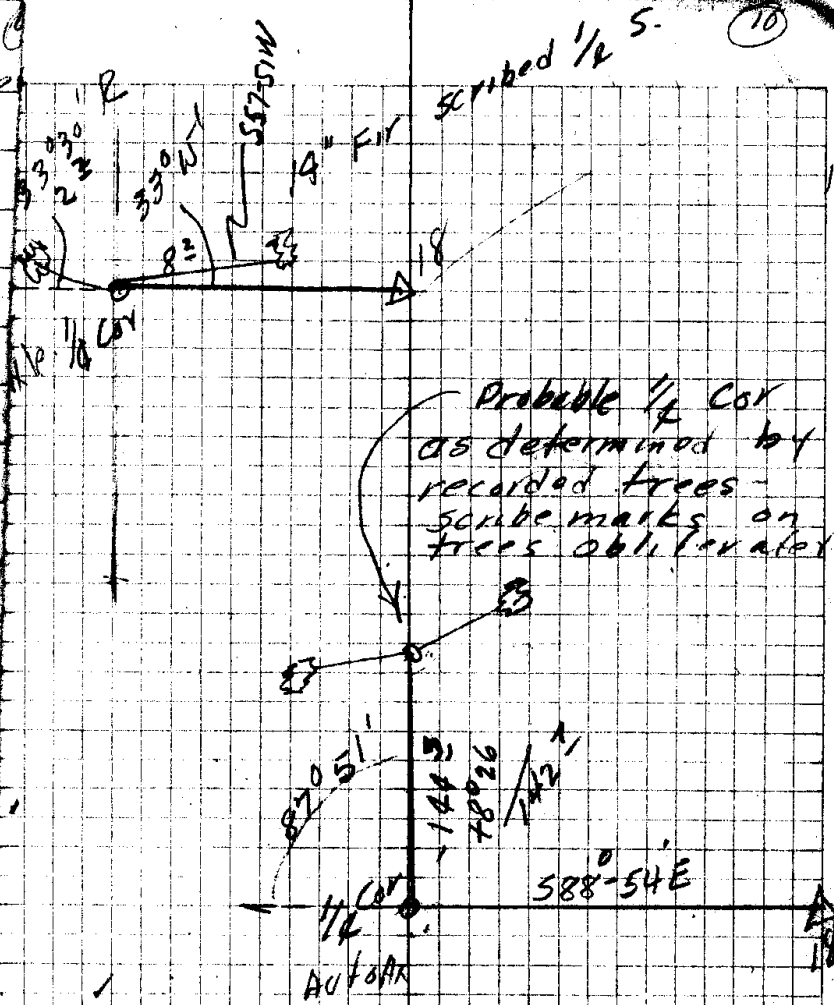

C.S. File No. 39/1711



3

34

27576

Sec Cor

9/8  
1817

7°

N26°59'30"E

52

25°42'R

N1°17'30"E

2780

Found Sec Cor ~~18~~ 1817 Pd in I.P.  
in mound of rock as per  
record - Three bearing trees alive  
and standing -

36" W. Oak - N 25° E - 31 Hrs. (O.B.T.)

15" W. Oak 55° E - 178 Hrs. (O.B.T.)

18" W. Oak 55° E - 165 Hrs. (E.B.T.)

MARKED 20" W. Oak - N 70° W 108°

C.S. ST. #2741

C.S. File No. 32/111

(41)

5083.96  
70

4202 ✓

N87°46'W ✓

173.0  
-902.2  
250.0

69

2027  
1014'R

3893

N89°00'W ✓

△ across river.

68

2006  
1003'R

589°57'W ✓


5273.8

(42)

147.000

170.7  
250.0  
420.7

8667 ✓

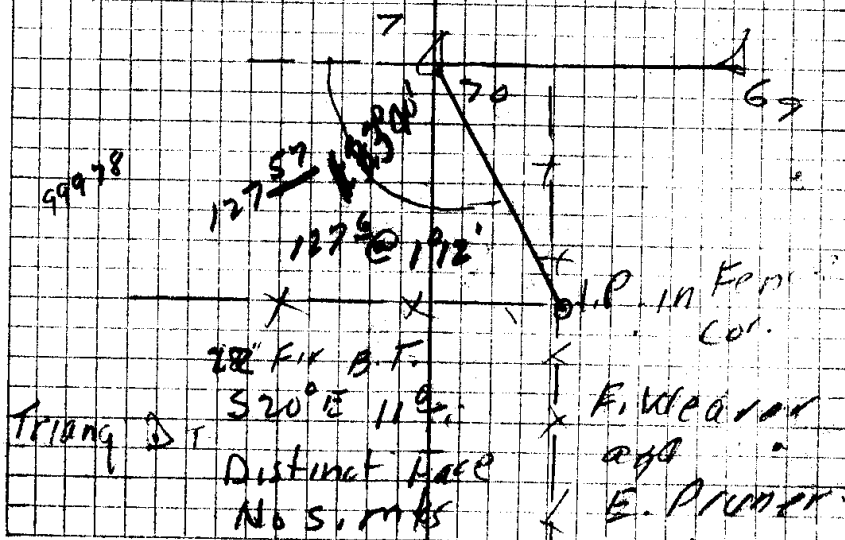


C.S. File No. 32171

18 B Oak N 13° W 117 ft  
 mtd. E. C. 1/6 5 18  
 BT 85

not mound.

2" x 36" / P 10

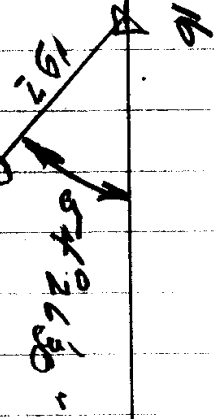

See 18

East Center 1/6 Sec 18

15 A

C. E. File No. 39/111

mtd 5 40 P E

mtd 8 14 18 14 8

CS BT

9° 39'

12 A

13 A

4/32

O

See 18  
 mtd 1/4 lot

500 18

Center 1/4

County Surveyors office

500 18

1' x 36" 1 P



w/ Brass Cop

501 E 18 1/4 N 11 1/2 E 135  
 mtd 8 14 18  
 CS BT

12" Oak N52°W 24.37' 1/4 Cor CS BT

1" x 3/8" Iron Pipe with Brass Cap mtd County Surveyor's Office

24" Oak S35°E 72.0' mtd 1/4 S 18 CS BT

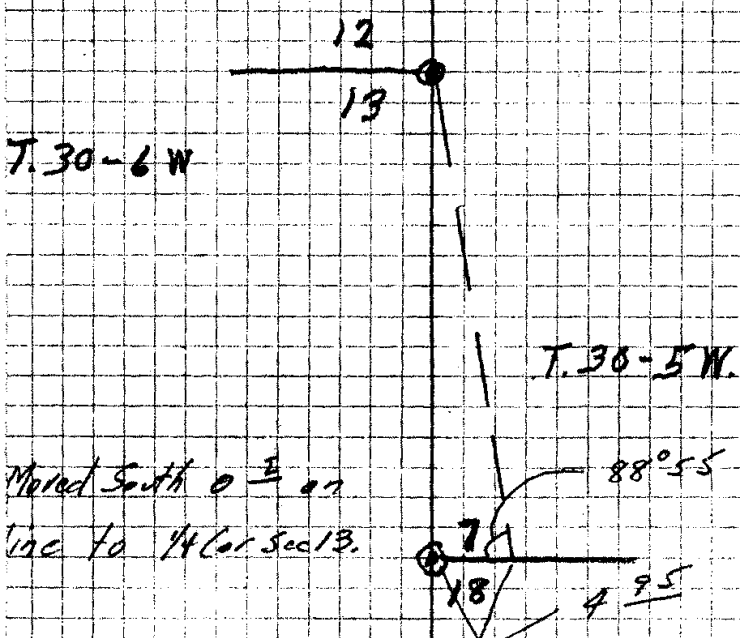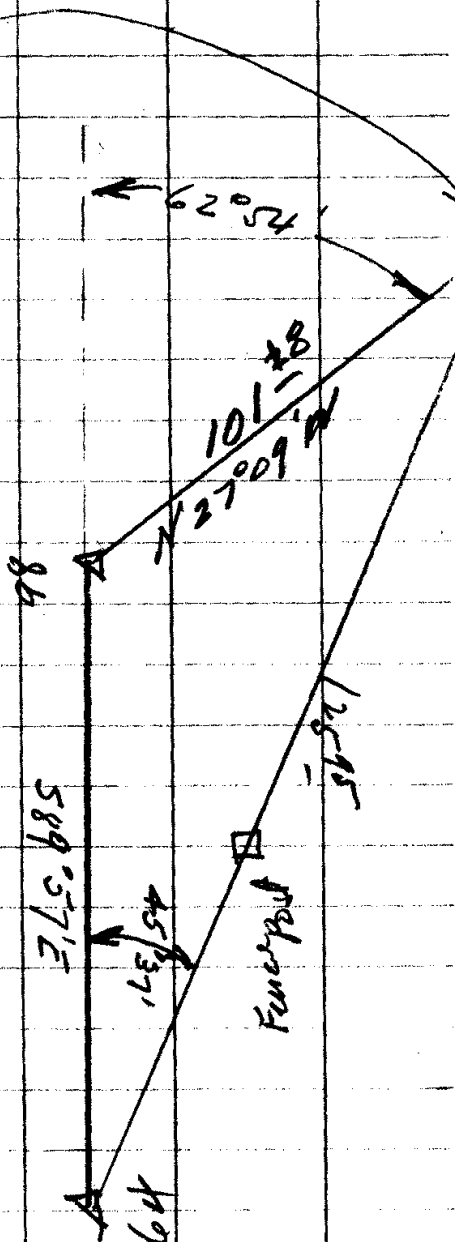

1" G.I.P. with Brass Cap  
Mtd Co. Surv. Off  
S 7/18 T 30 S - R 5 W.

28" Oak - ~~30"~~ Oak N25°W 149.5'  
Mtd. 5-13-T30-S-R6-W  
12" Bull Pine 556 1/4' E, 68°  
Mtd 3-18 T30S-R5-W

Both - CS. B. T. *Red*

C.S. File No. 39/511

CS FILE FOLDER

CONTAINS

MORE

INFORMATION