

# MAP OF SURVEY LOT 9 FRUITVALE


COUNTY SURVEYORS FILE WITH  
DO NOT REMOVE FROM OFFICE

T27W · R5W · W1M.  
Surveyed & Platted By  
**JAMES R. DAUGHERTY**  
Civil-Sanitary Engineer  
REGISTERED PROFESSIONAL ENGR.


ROSEBURG, ORE.  
I.P.

D.P. BARNES D.L.C. #39  
1556.9'

2327.10

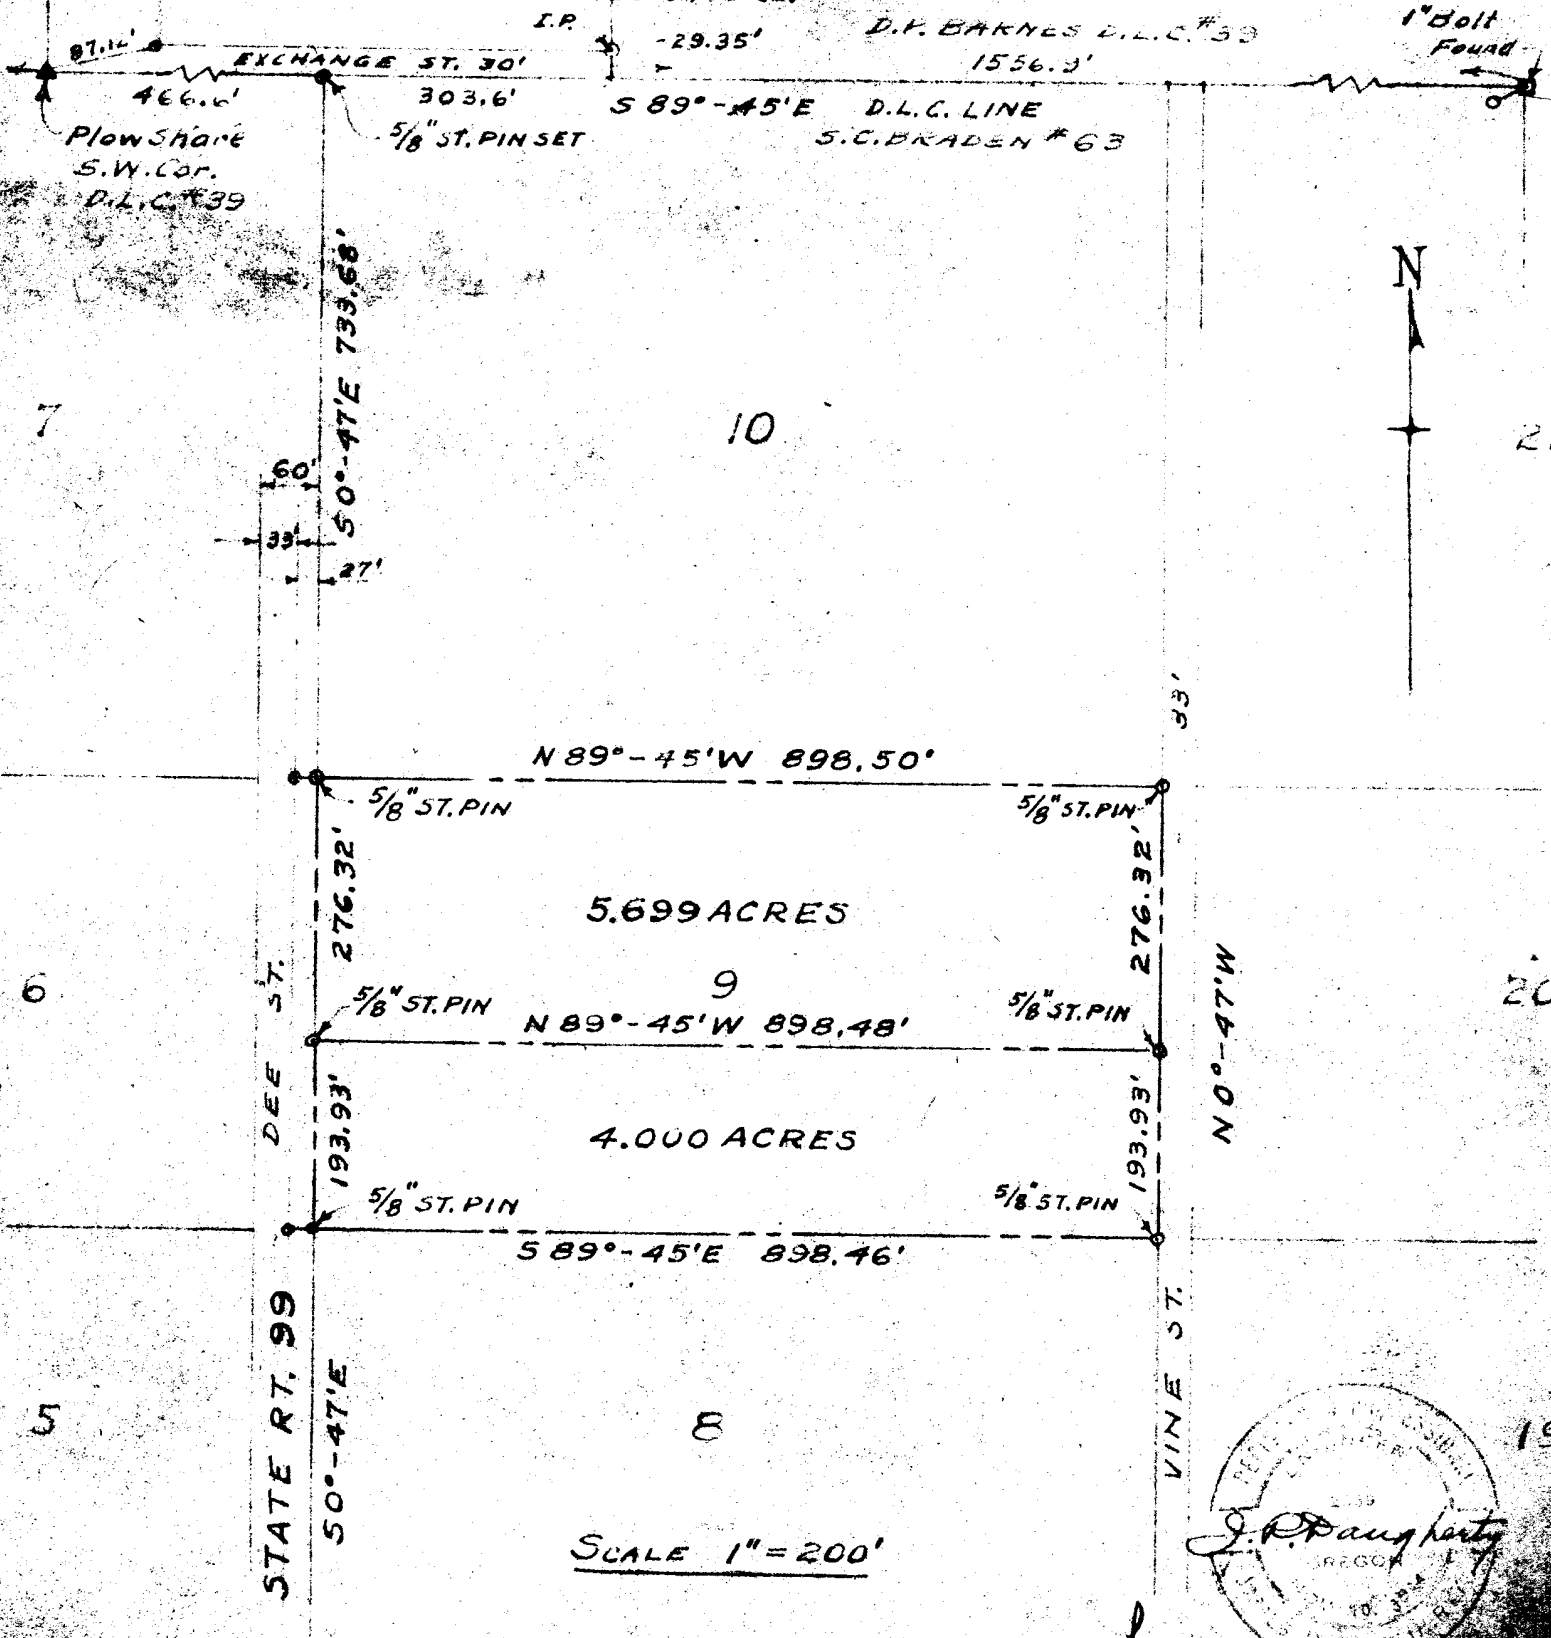

SCALE 1" = 200'

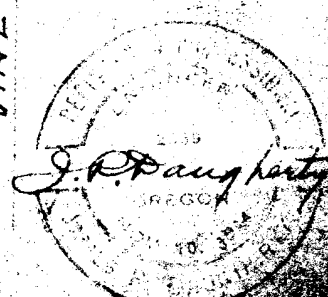

June 2, 1948

C.S. ENR. NO. 251

CS FILE FOLDER

CONTAINS

MORE

INFORMATION