


2534
99976
299.2
99898
2995
99947
298
99491
2356
9
2869
95345

Fd 1 1/4" I.P.

Fd 1 1/4" I.P. previously located by
B.B.I. C.S.

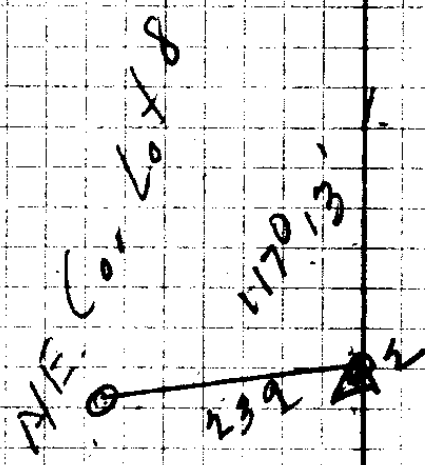

239

Int P

~~CLL B.B.I. 32/180~~

NW Cor
Lot 3

68⁹

S 37⁰ 16' W

NW
Cor 4

178⁰ 58'
89⁰ 29' L

S 39⁰ W

836⁷

N 53⁰ 15' W

N 51⁰ 30' W

150⁴
187⁹ L
293³
-1015'
265⁴
-3007

NW Cor
Lot 8

0⁰ 11'
0⁰ 06' L

240⁹
-2033'

240⁷

N 53⁰ 09' W

N 51⁰ 11' W

2

28⁰ 26'
64⁰ 13' R

Int
pt

S 62⁰ 38' W

~~U.S. File No. 391180~~

McClintock —
Tie from $\frac{1}{4}$ Cor 33/34 T 29-R5
to Int. Pt. Krimback Plat.

6-17-48

H. R. EVANS T
M. E. Godfrey W.C.
L. S. Kershner R.C.

5-19-48

Found 1 1/4" Water Pipe
(1 3/4" outside diam) at a fence
corner.

Shown this as 1/4
sec. corner between secs
33-34 T 29 S R 5 W W.M.
by Ray Norton at
Myrtle Creek -

Deputy G. Sumner Freer
Nov 15-18, 1917 records
1/4 cor bet. secs. 33 & 34
T 29 S R 5 W W.M. as a
2" ~~3/4"~~ Gal P and chilled
plow share, plow

Upon digging found a
chilled plow share lying
down 4" underground.

Reset plow share so that
point was up and even
with ground & fence intersect
about 2' North.

Ben Blivington Survey -
Carl Falke

Office Memorandum

2

S 63-19W

562^{038'}

56°

562W

Int Pt.
K.I. Plot

95°28'
47°44'

2535
-1015'

300°
-2°35'

N 68-57W

1151'

N 69°38'W

300°
-3°10'

N 68°30'W

300°
-5°47'

2985

0°10'

1

0°05' N 68-52W

239
-10°28'

N 69°33'W / N 69°30'W

5216'

300°
-17°33'

1/4

Cor

33/34

59976 233.2f -

99854 265.01 -

99901 ✓ = 240.62

~~62112 321180~~

SW Cor
Plot

102[±]
-2°39'

103[±]

S45°41'W

NW Lot
1

5°35'
2°47'R

S36°10'W

98[±]

S42°34'W

S44°3/4'W

SW Cor
Lot 3

7°45'
3°53'R

100⁰⁵

S39°01'W

S41°3/4'W

NW Cor
Lot 3

3°30'
1°45'R

S37°16'W

99893

U. S. Fish & Wildlife Service
20/180

NE Cor
Lot 1
Bik 2

275⁴₋

544⁰₅₀¹₄

543⁰E

NE Cor
Briggs

186⁰58'
90⁰29'_L

545⁰₃₉¹_W

289²₋

546¹₄W

SW Cor
Klim.

0⁰0¹
0⁰02'_L

545⁰₁¹_W

875

875 -- NE #2

1004 NE #21

N.W. Cor.

U. S. File No. 351180

C.

775[±]

B

24°38'
12°19' L

N22½ E

576[±]

A

35°18'
17°39' R

N34½ E

38[±]

N16½ E

NW cor
cot 4
Klim

44°36'
22°28' L

Q. & P. No. 32180

E

446⁵

D

1036'
0°48'L

N7½E

610³

C

27°32'
13°46'L

N8¼E

CS FILE FOLDER

CONTAINS

MORE

INFORMATION