


NOTE -
 Record Tract map shows impossible condition along Easterly boundaries of Lots 6, 7, 8, & 9. Lines, as shown hereon, were established by using found pipes on N'y line of Lot 6 & S'y line of Lot 9, distance prorated to fix division lines, and using Record distances from Benson St

**COUNTY SURVEYOR'S OFFICE
 DOUGLAS COUNTY, OREGON**

SURVEY TO ESTABLISH LOTS 6-10 INCL., BLOCK I, WAITE'S ADDITION.

BEN. B. IRVING COUNTY SURVEYOR
 SURVEYED AUGUST 20, 1948. BY
 N.E. RICHARDSON DEPUTY

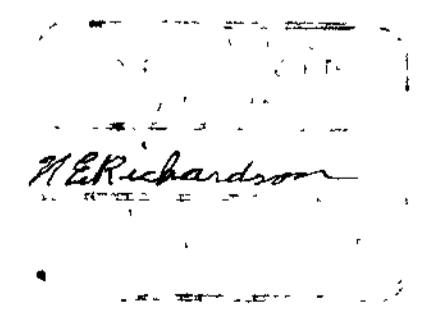

**COUNTY SURVEYORS FILE DATA
 DO NOT REMOVE FROM OFFICE**

SCALE 1" = 40'