


NE Cor.
Q 52
T25S, R5W

CS. 40/15

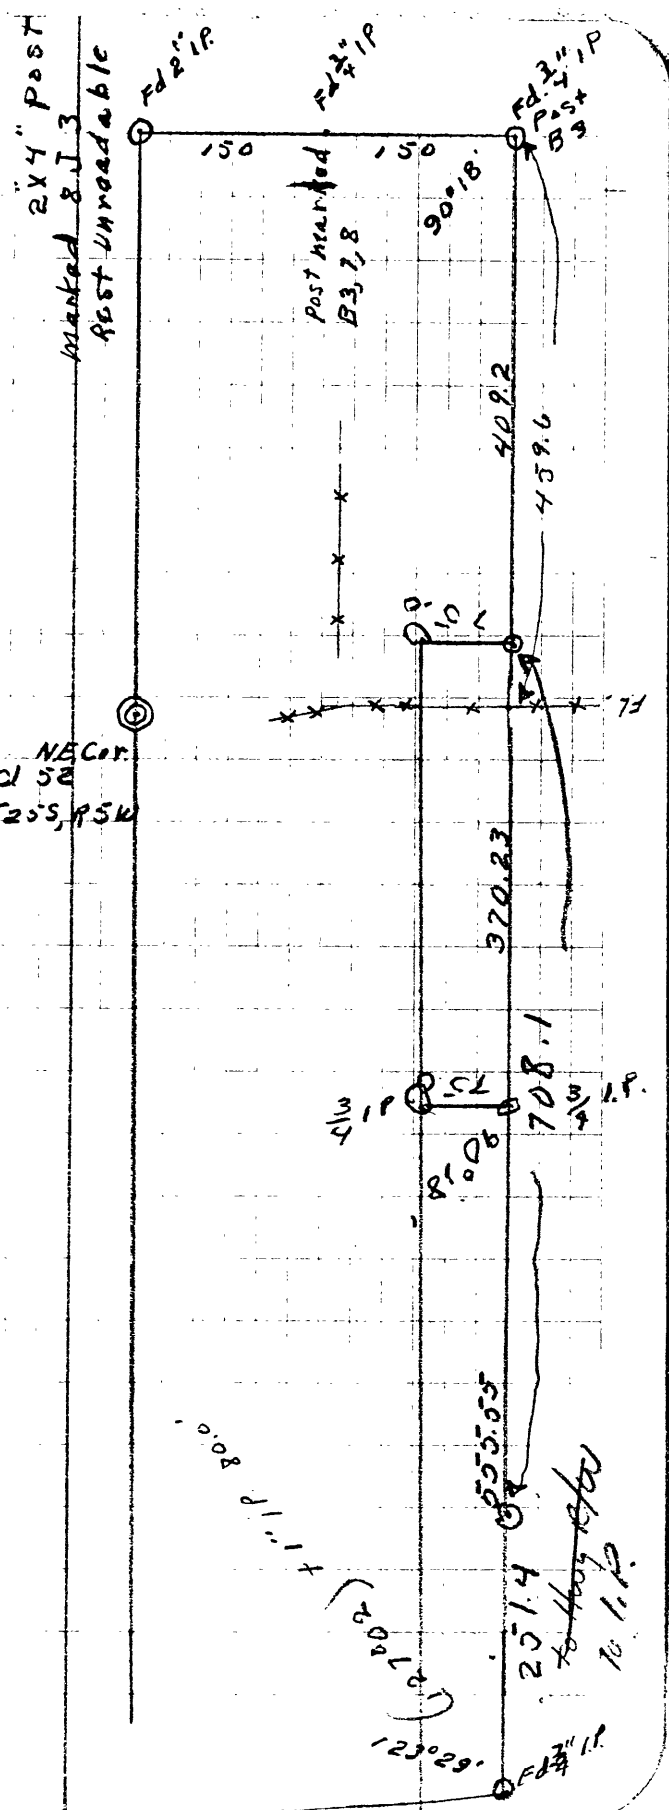

CS FILE FOLDER

CONTAINS

MORE

INFORMATION