






Mr B + Catherine Dobbins

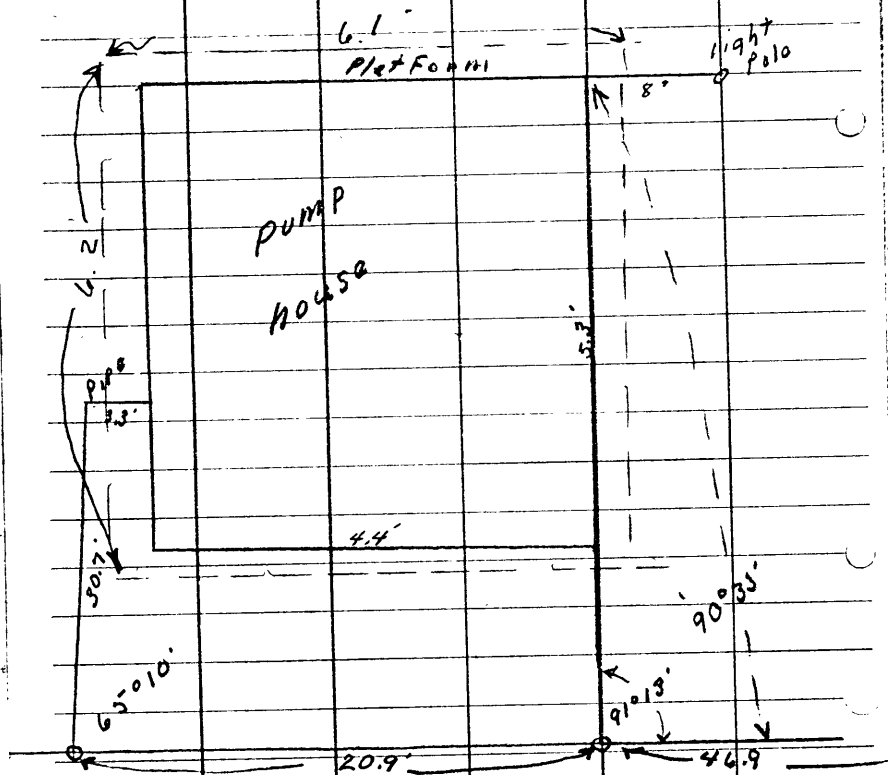

CS FILE FOLDER

CONTAINS

MORE

INFORMATION