

SW Cor  
Sec 16

INITIAL POINT  
GLEN D. HART TRACT  
2" I.P.


# 'GLEN D. HART' TRACT

JAN. 1946

SCALE: 1" = 200'

SEC. 21, T28S, R8W, W.M.

COUNTY SURVEYORS FILE DATA  
DO NOT REMOVE FROM OFFICE

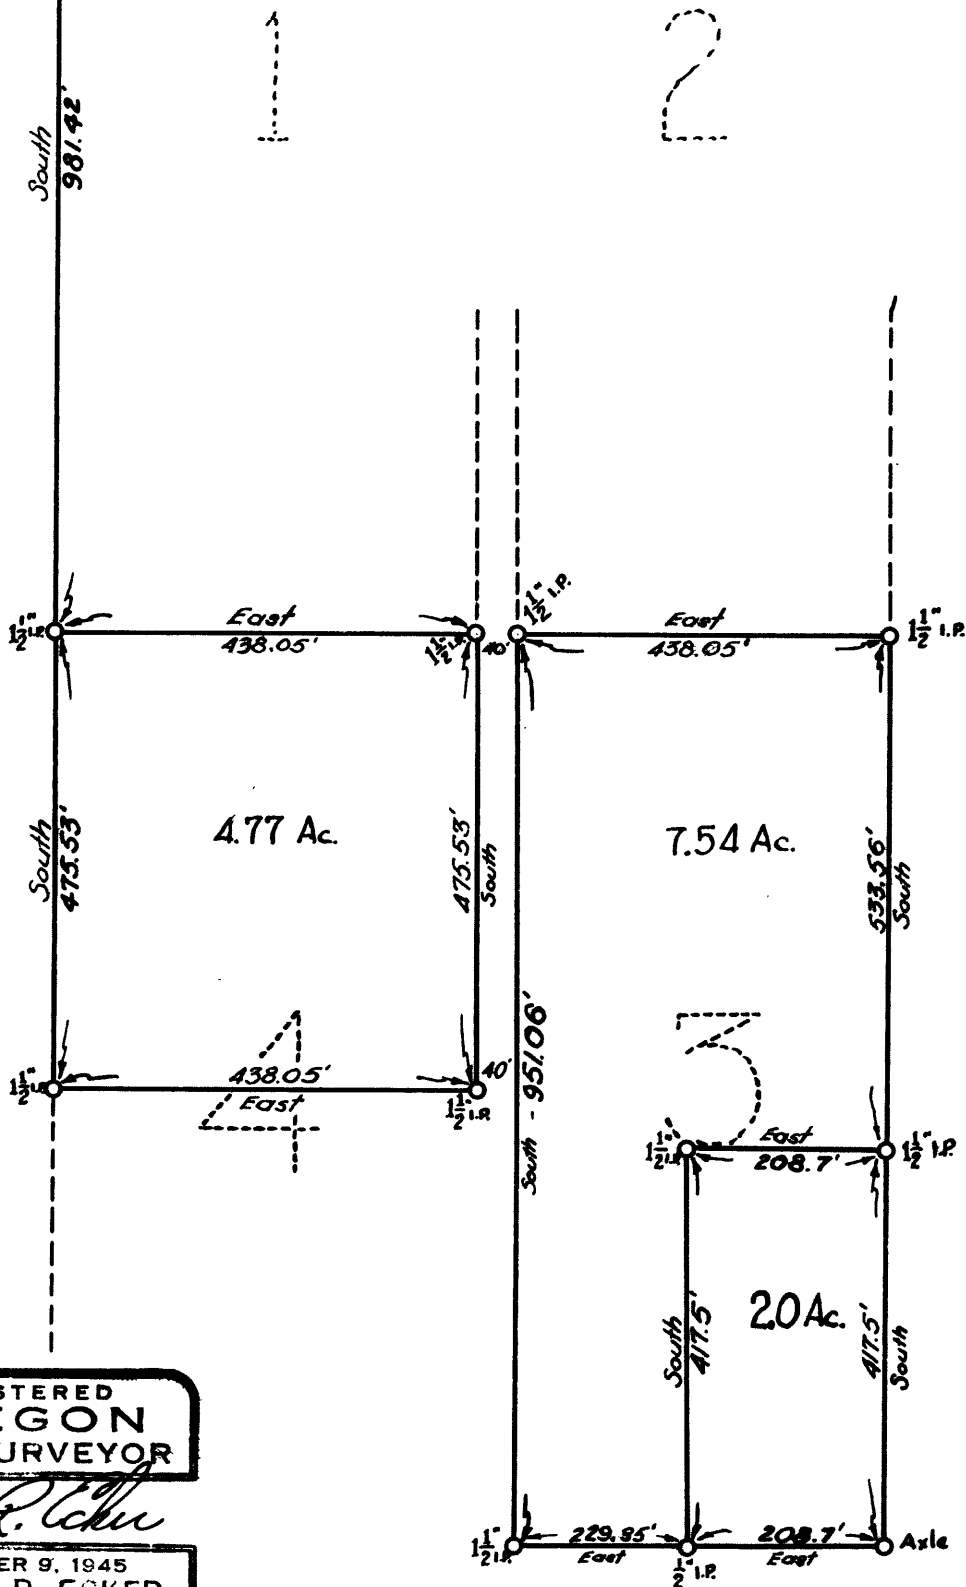

REGISTERED  
OREGON  
LAND SURVEYOR

*Richard R. Ecker*

NOVEMBER 9, 1945  
RICHARD R. ECKER  
158

CS FILE FOLDER

CONTAINS

MORE

INFORMATION