
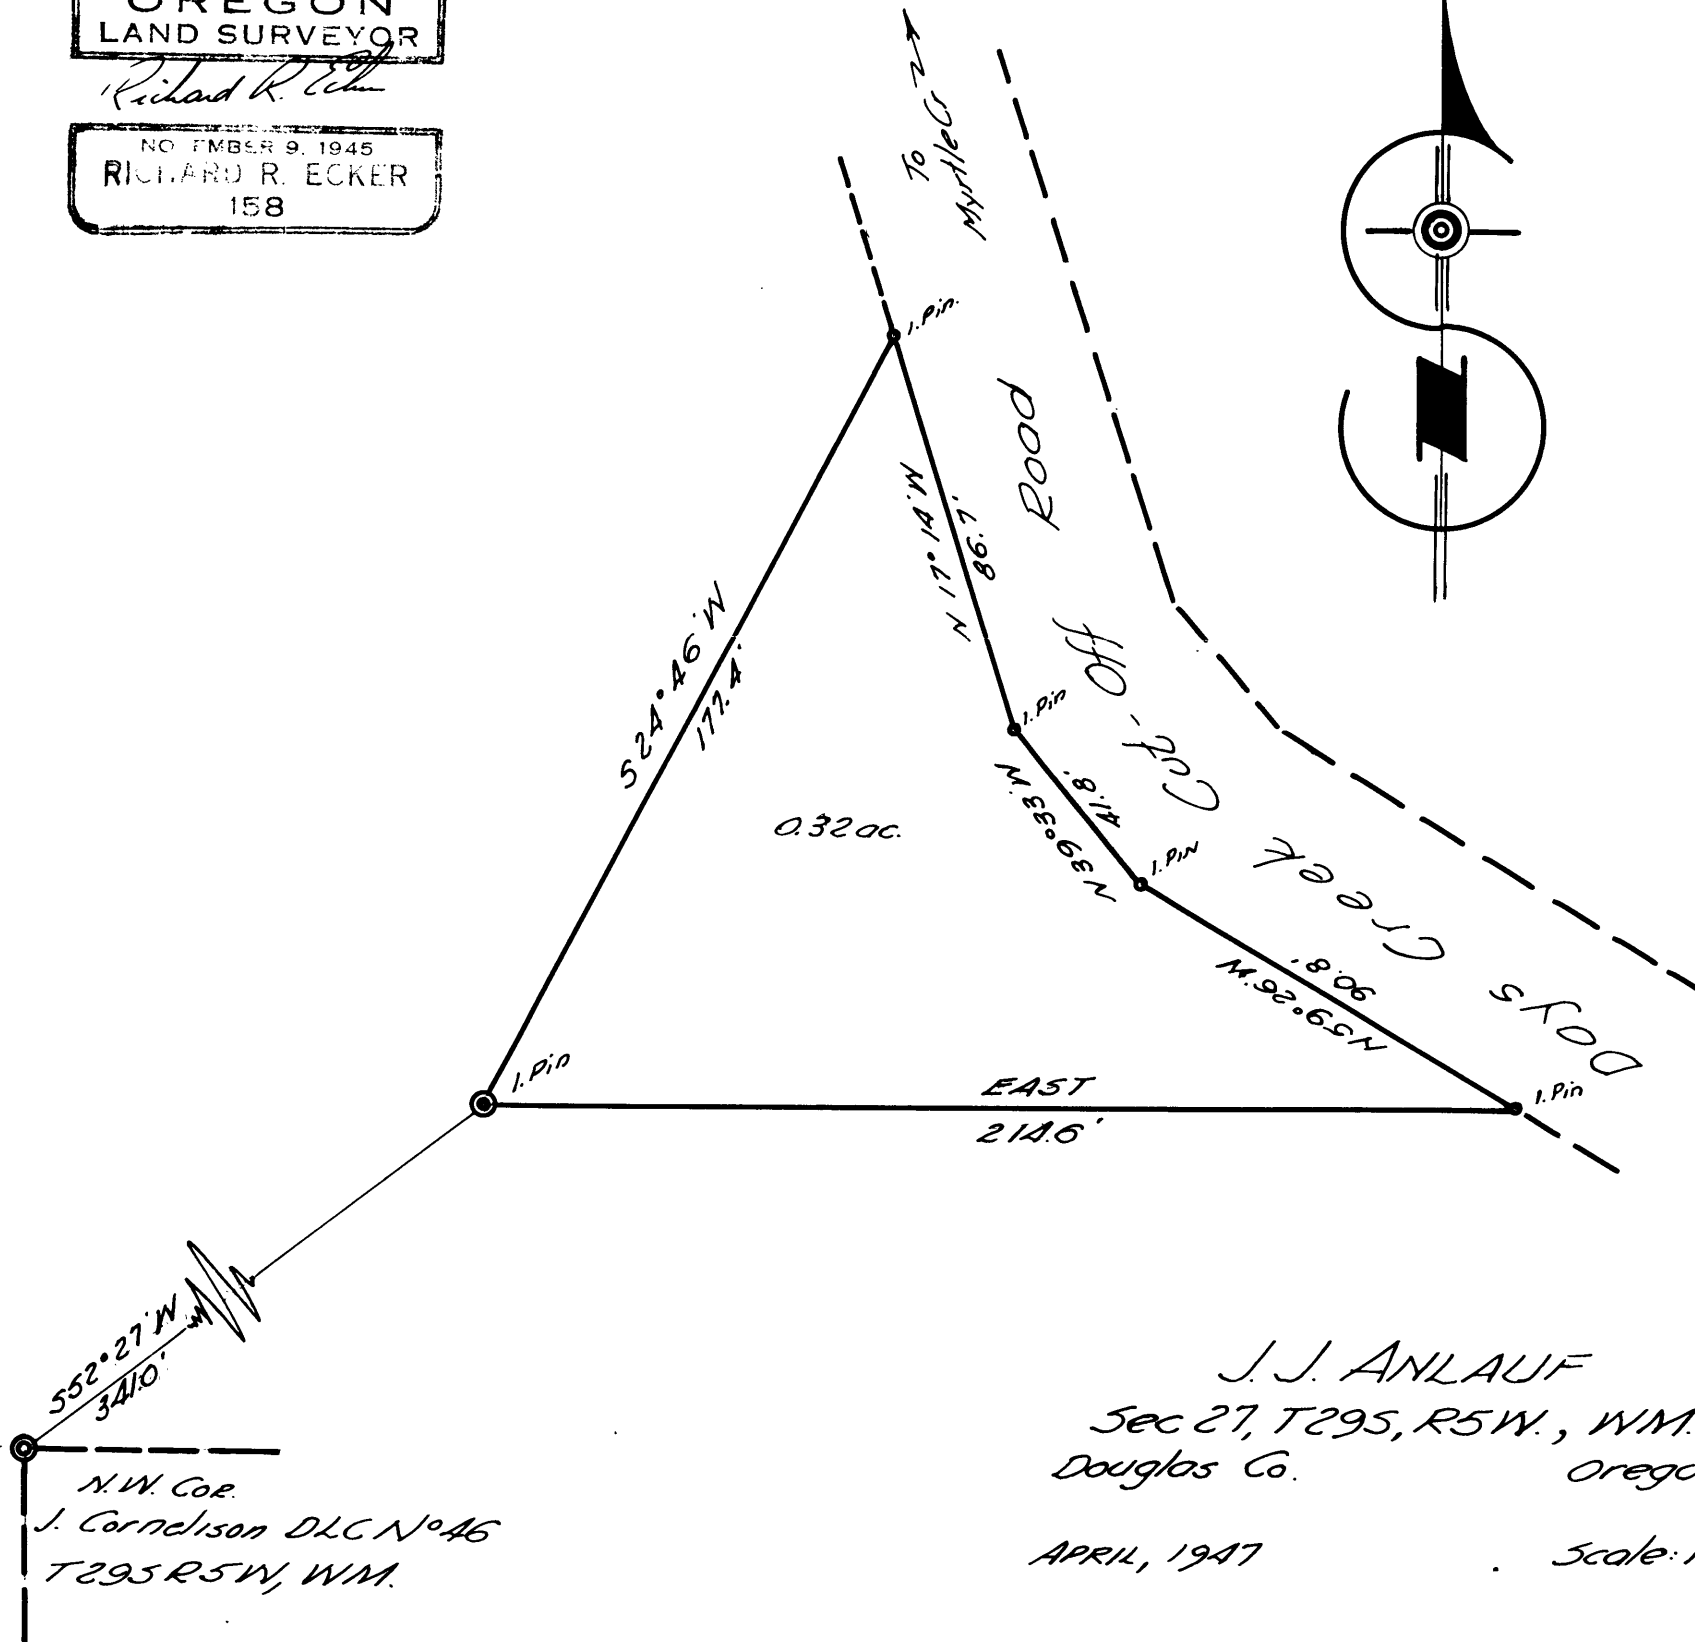


COUNTY SURVEYORS FILE DATA  
DO NOT REMOVE FROM OFFICE

REGISTERED  
OREGON  
LAND SURVEYOR

*Richard R. Ecker*

NO FEMER 9, 1945  
RICHARD R. ECKER  
158

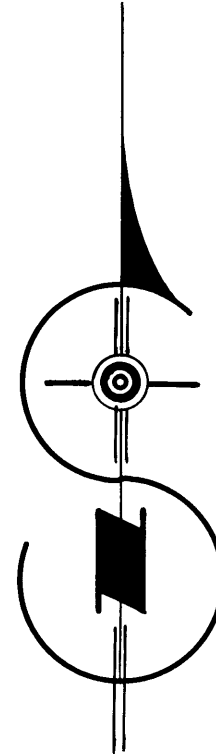

J. J. ANLAUF  
Sec 27, T295, R5W., WM.  
Douglas Co. Oregon

APRIL, 1947

Scale: 1"=40'

CS FILE FOLDER

CONTAINS

MORE

INFORMATION