


Exterior boundaries plot reasonable
Exception is impossible

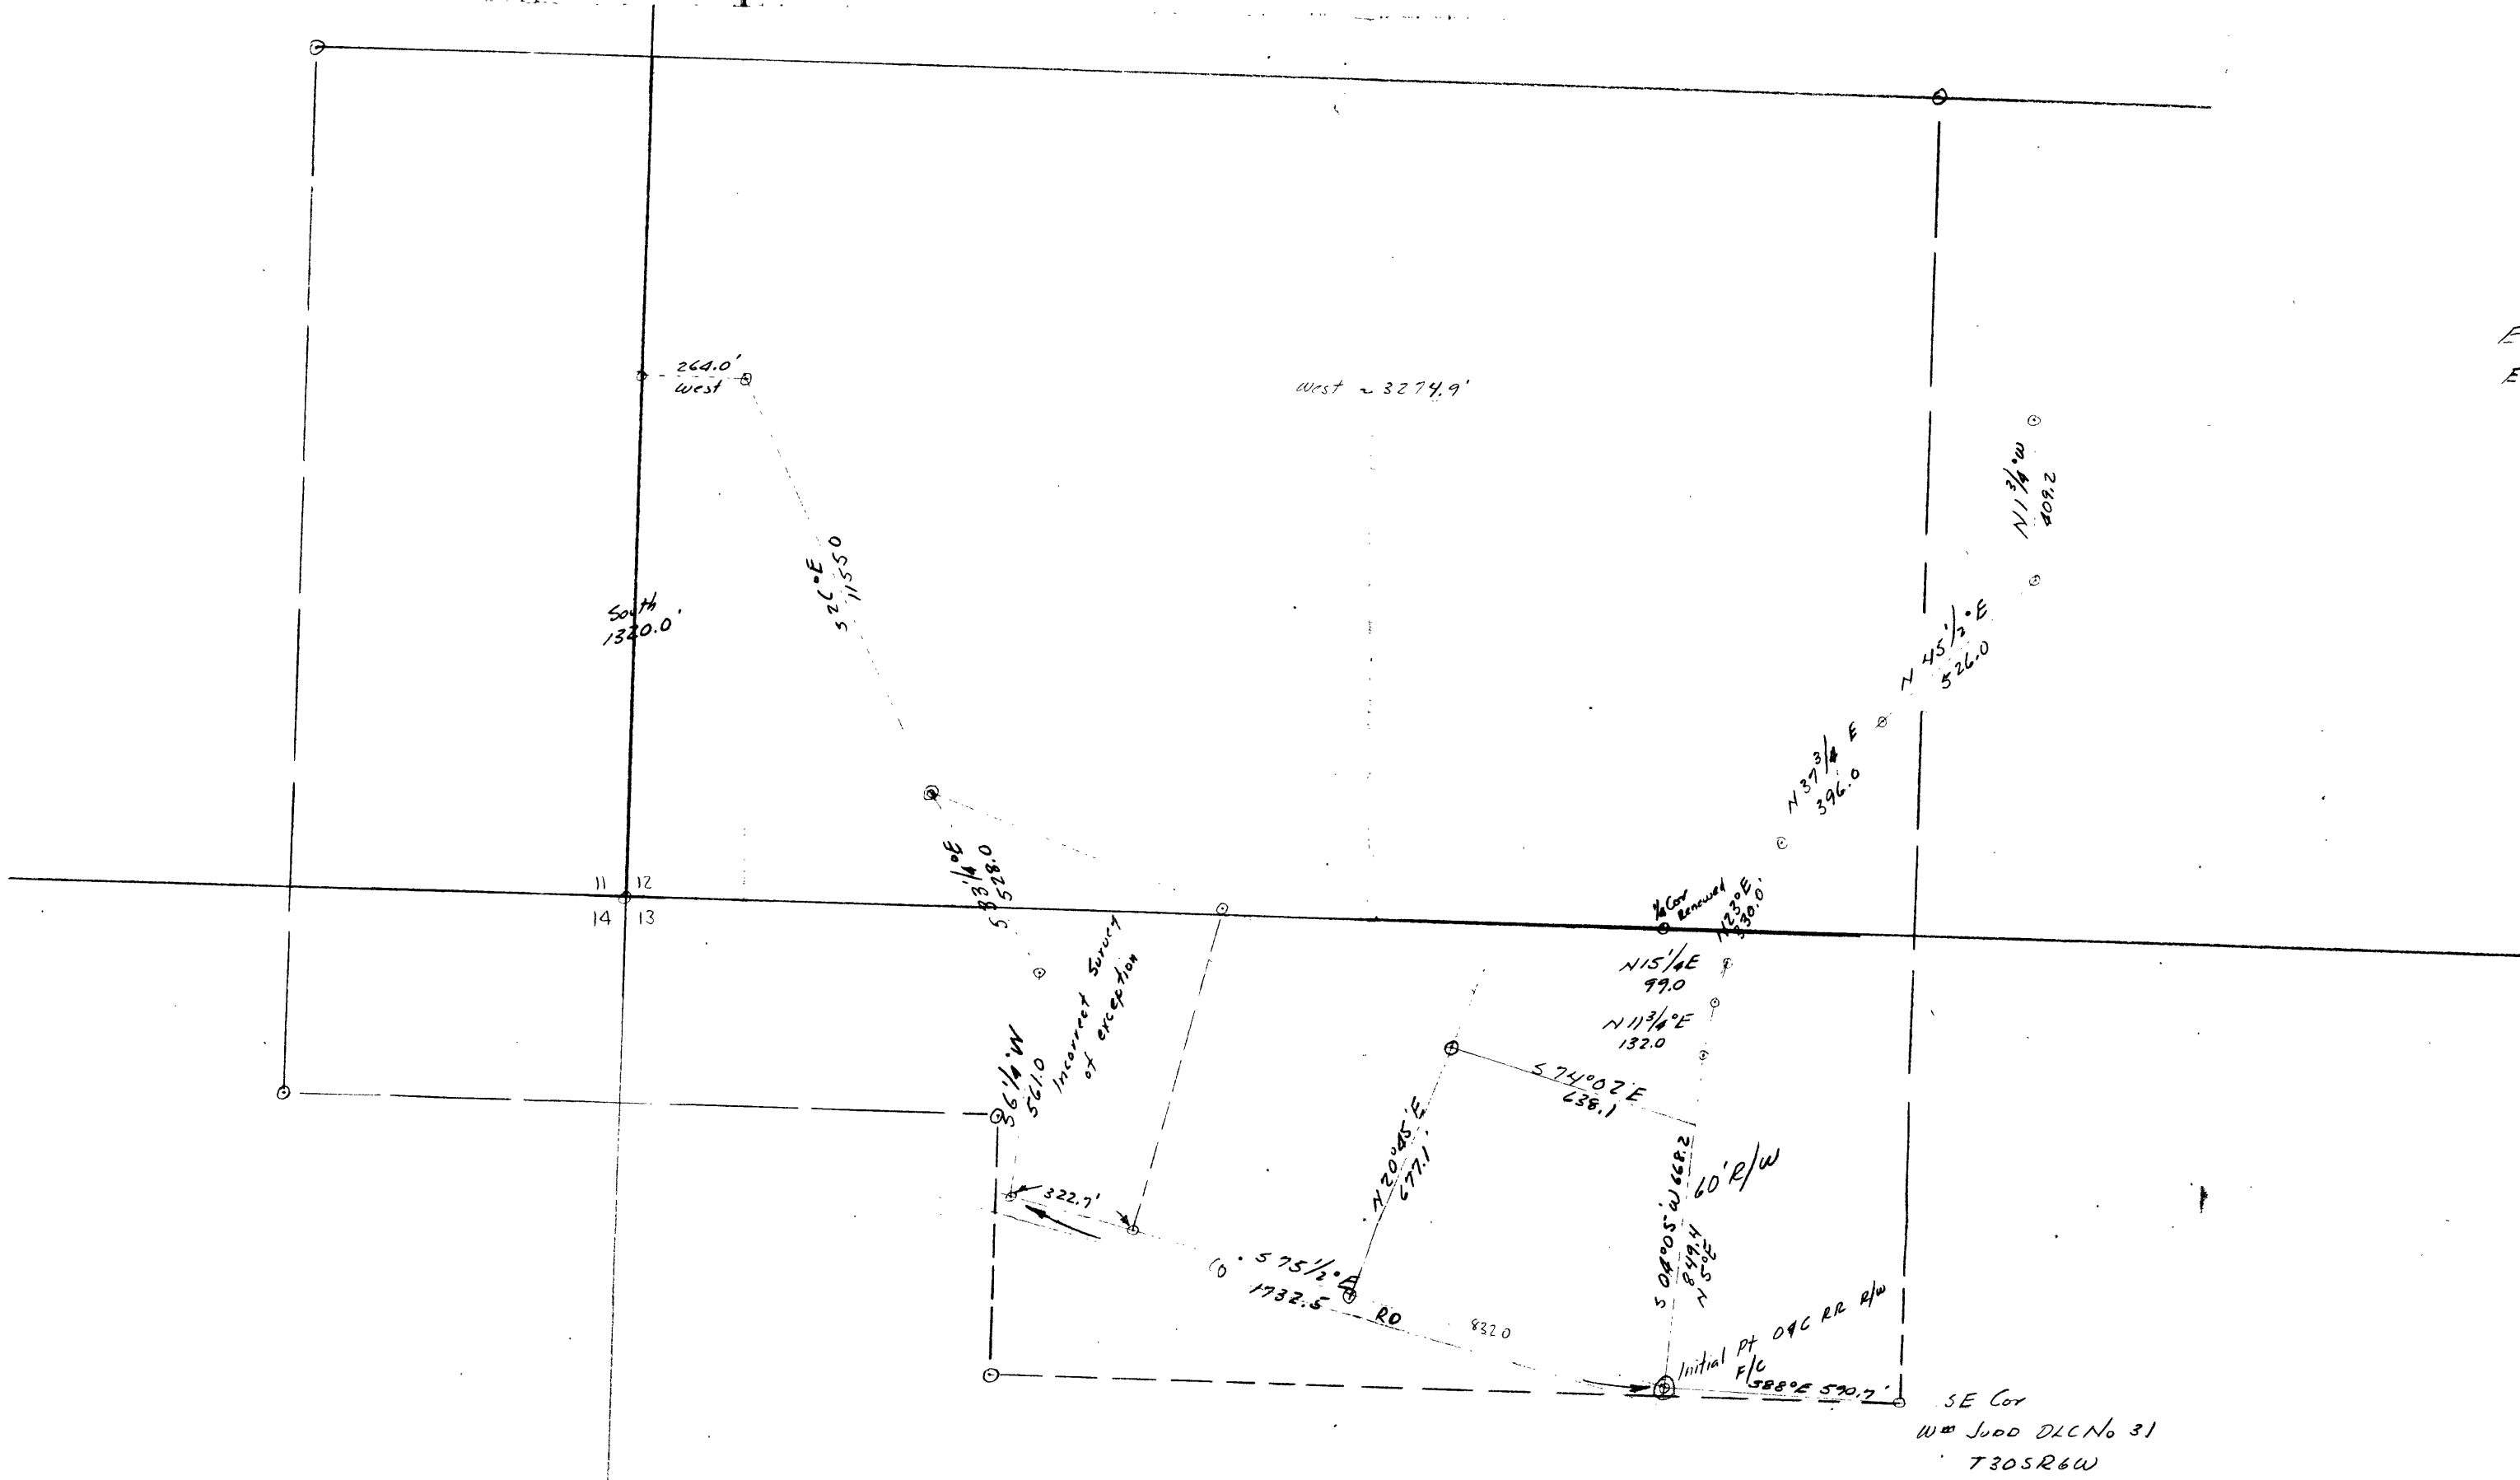

75 30

MARK RENHARDT
RIDDLE, ORE

T 30SR6W 1" = 200'

6/Mar/57

RR E

CS FILE FOLDER

CONTAINS

MORE

INFORMATION