


REGISTERED
OREGON
LAND SURVEYOR

Richard R. Ecker

NOVEMBER 9, 1945
RICHARD R ECKER
158

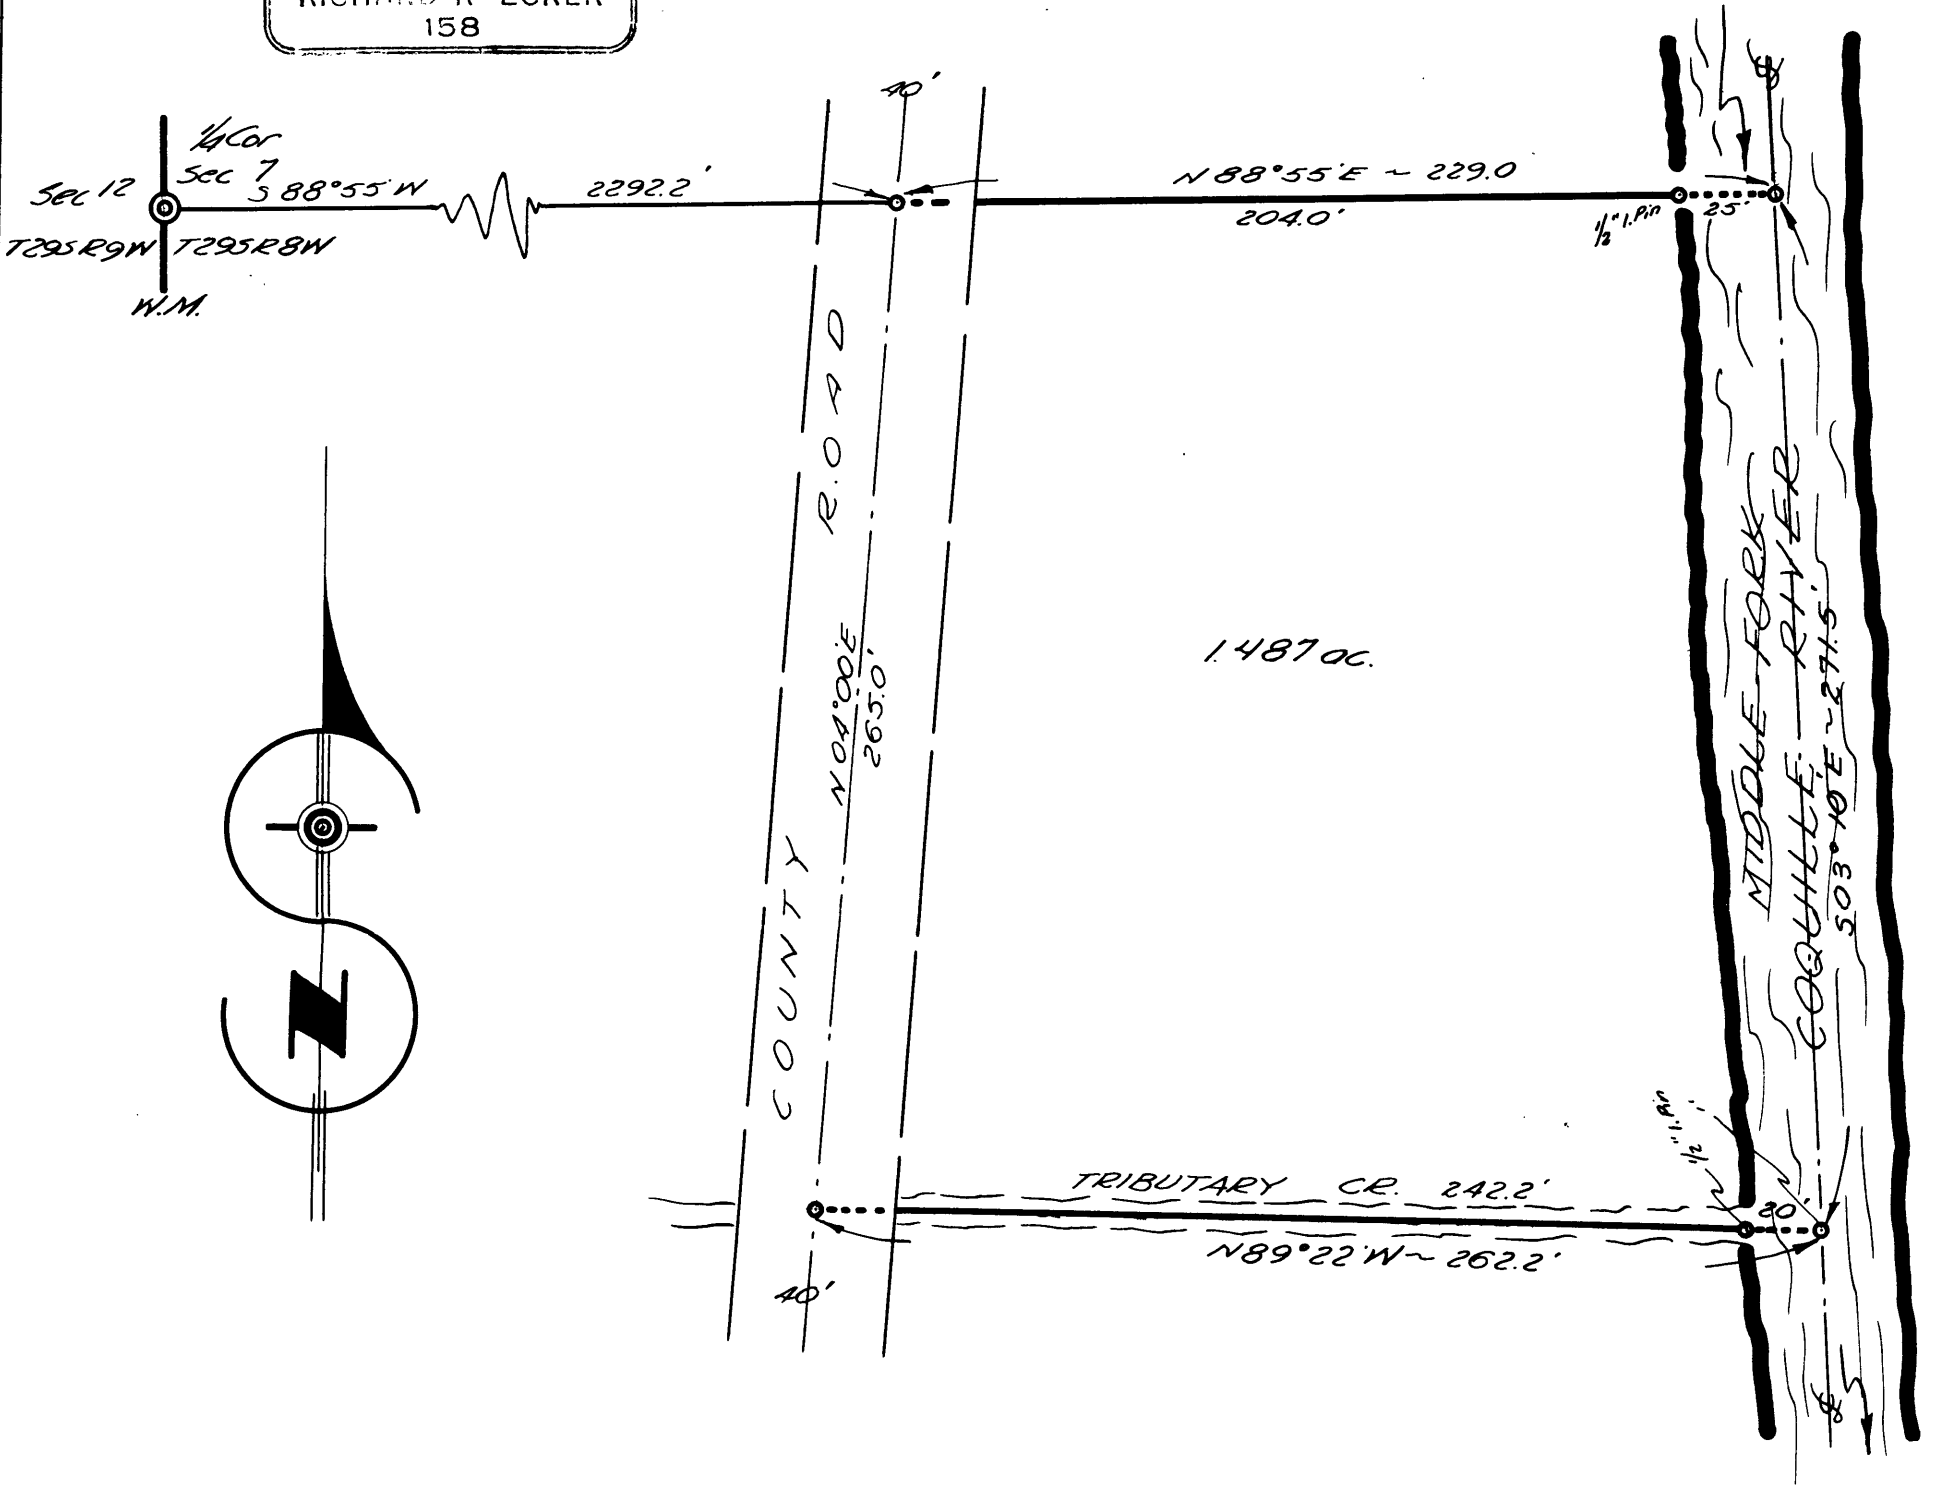

JACOB ROBBINS
SW 1/4 Sec 7, T295, R8W, W.M.
Douglas Co. Oregon

July, 1947

Scale: 1" = 50'

COUNTY SURVEYORS FILE DATA
DO NOT REMOVE FROM OFFICE

Survey for Jacob Robbins SW 1/4 Section 7, T29S, R8", W.M.

From the West 1/4 corner (Var 20) this survey was established from the original description of the property and this parcel was cut off.

The original notes are attached

The original plat is attached

No discrepancies are noted.

By
R.R. Ecker. L.S. 158

FILED
RECEIVED

14 1948

COUNTY SURVEYOR
DOUGLAS COUNTY, ORE.

CS FILE FOLDER

CONTAINS

MORE

INFORMATION