

C.S. Plan No. 40/67

42030
22
100


BLAKELY

BROCKWAY

JACKSON ST.

HAMILTON ST.

DRAWER 40 FILE 67

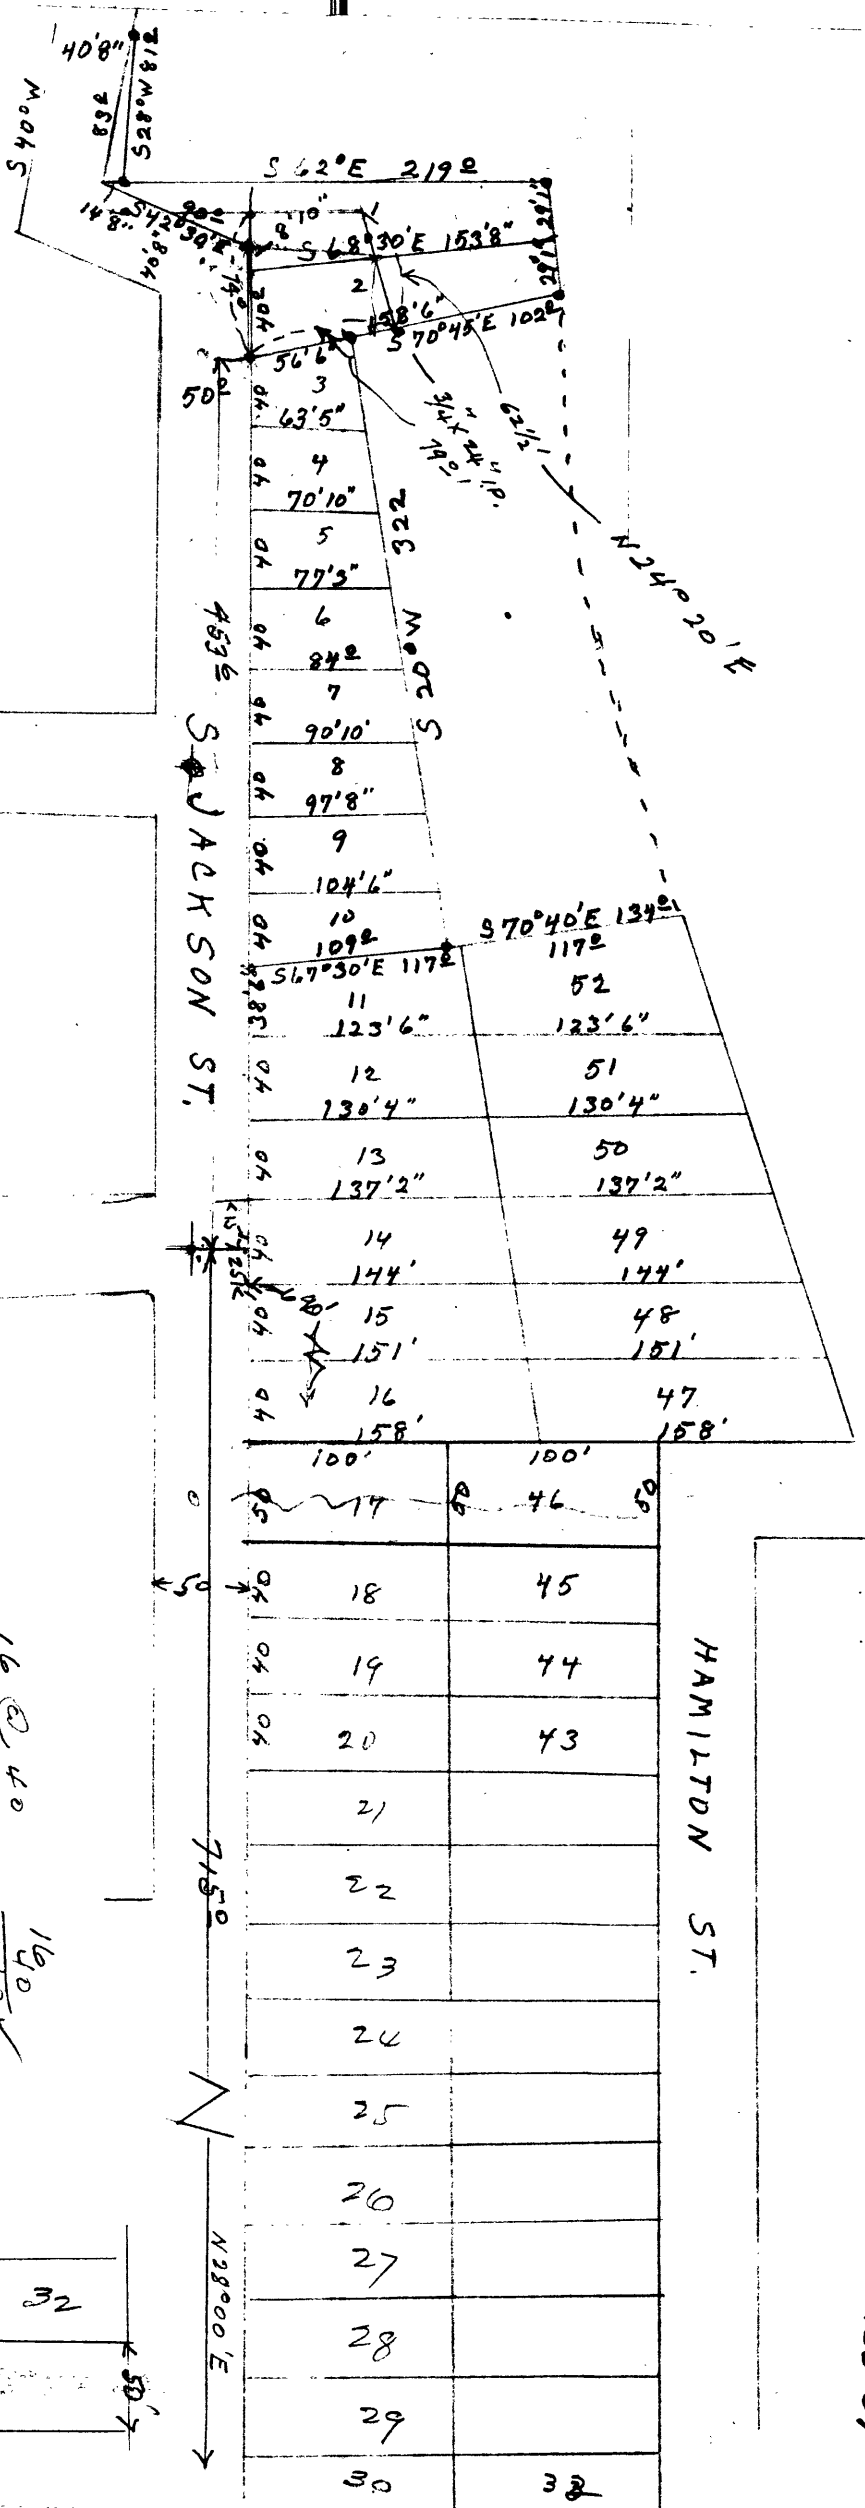

40
400 ✓
386 ✓
15
459.6

320 ✓
345 ✓
320 ✓
25 ✓
715

160
640
650
690


715
690
25

690
25
715

16 @ 40
57.50' ✓
50' ✓

160 ✓
640
100
740

140
680
650
730

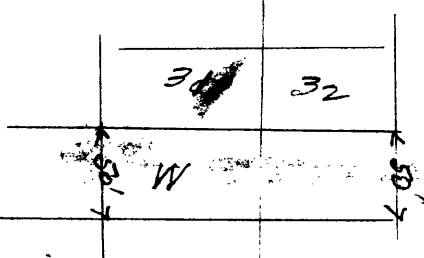

715.0

N 28° 00' E

CS FILE FOLDER

CONTAINS

MORE

INFORMATION