
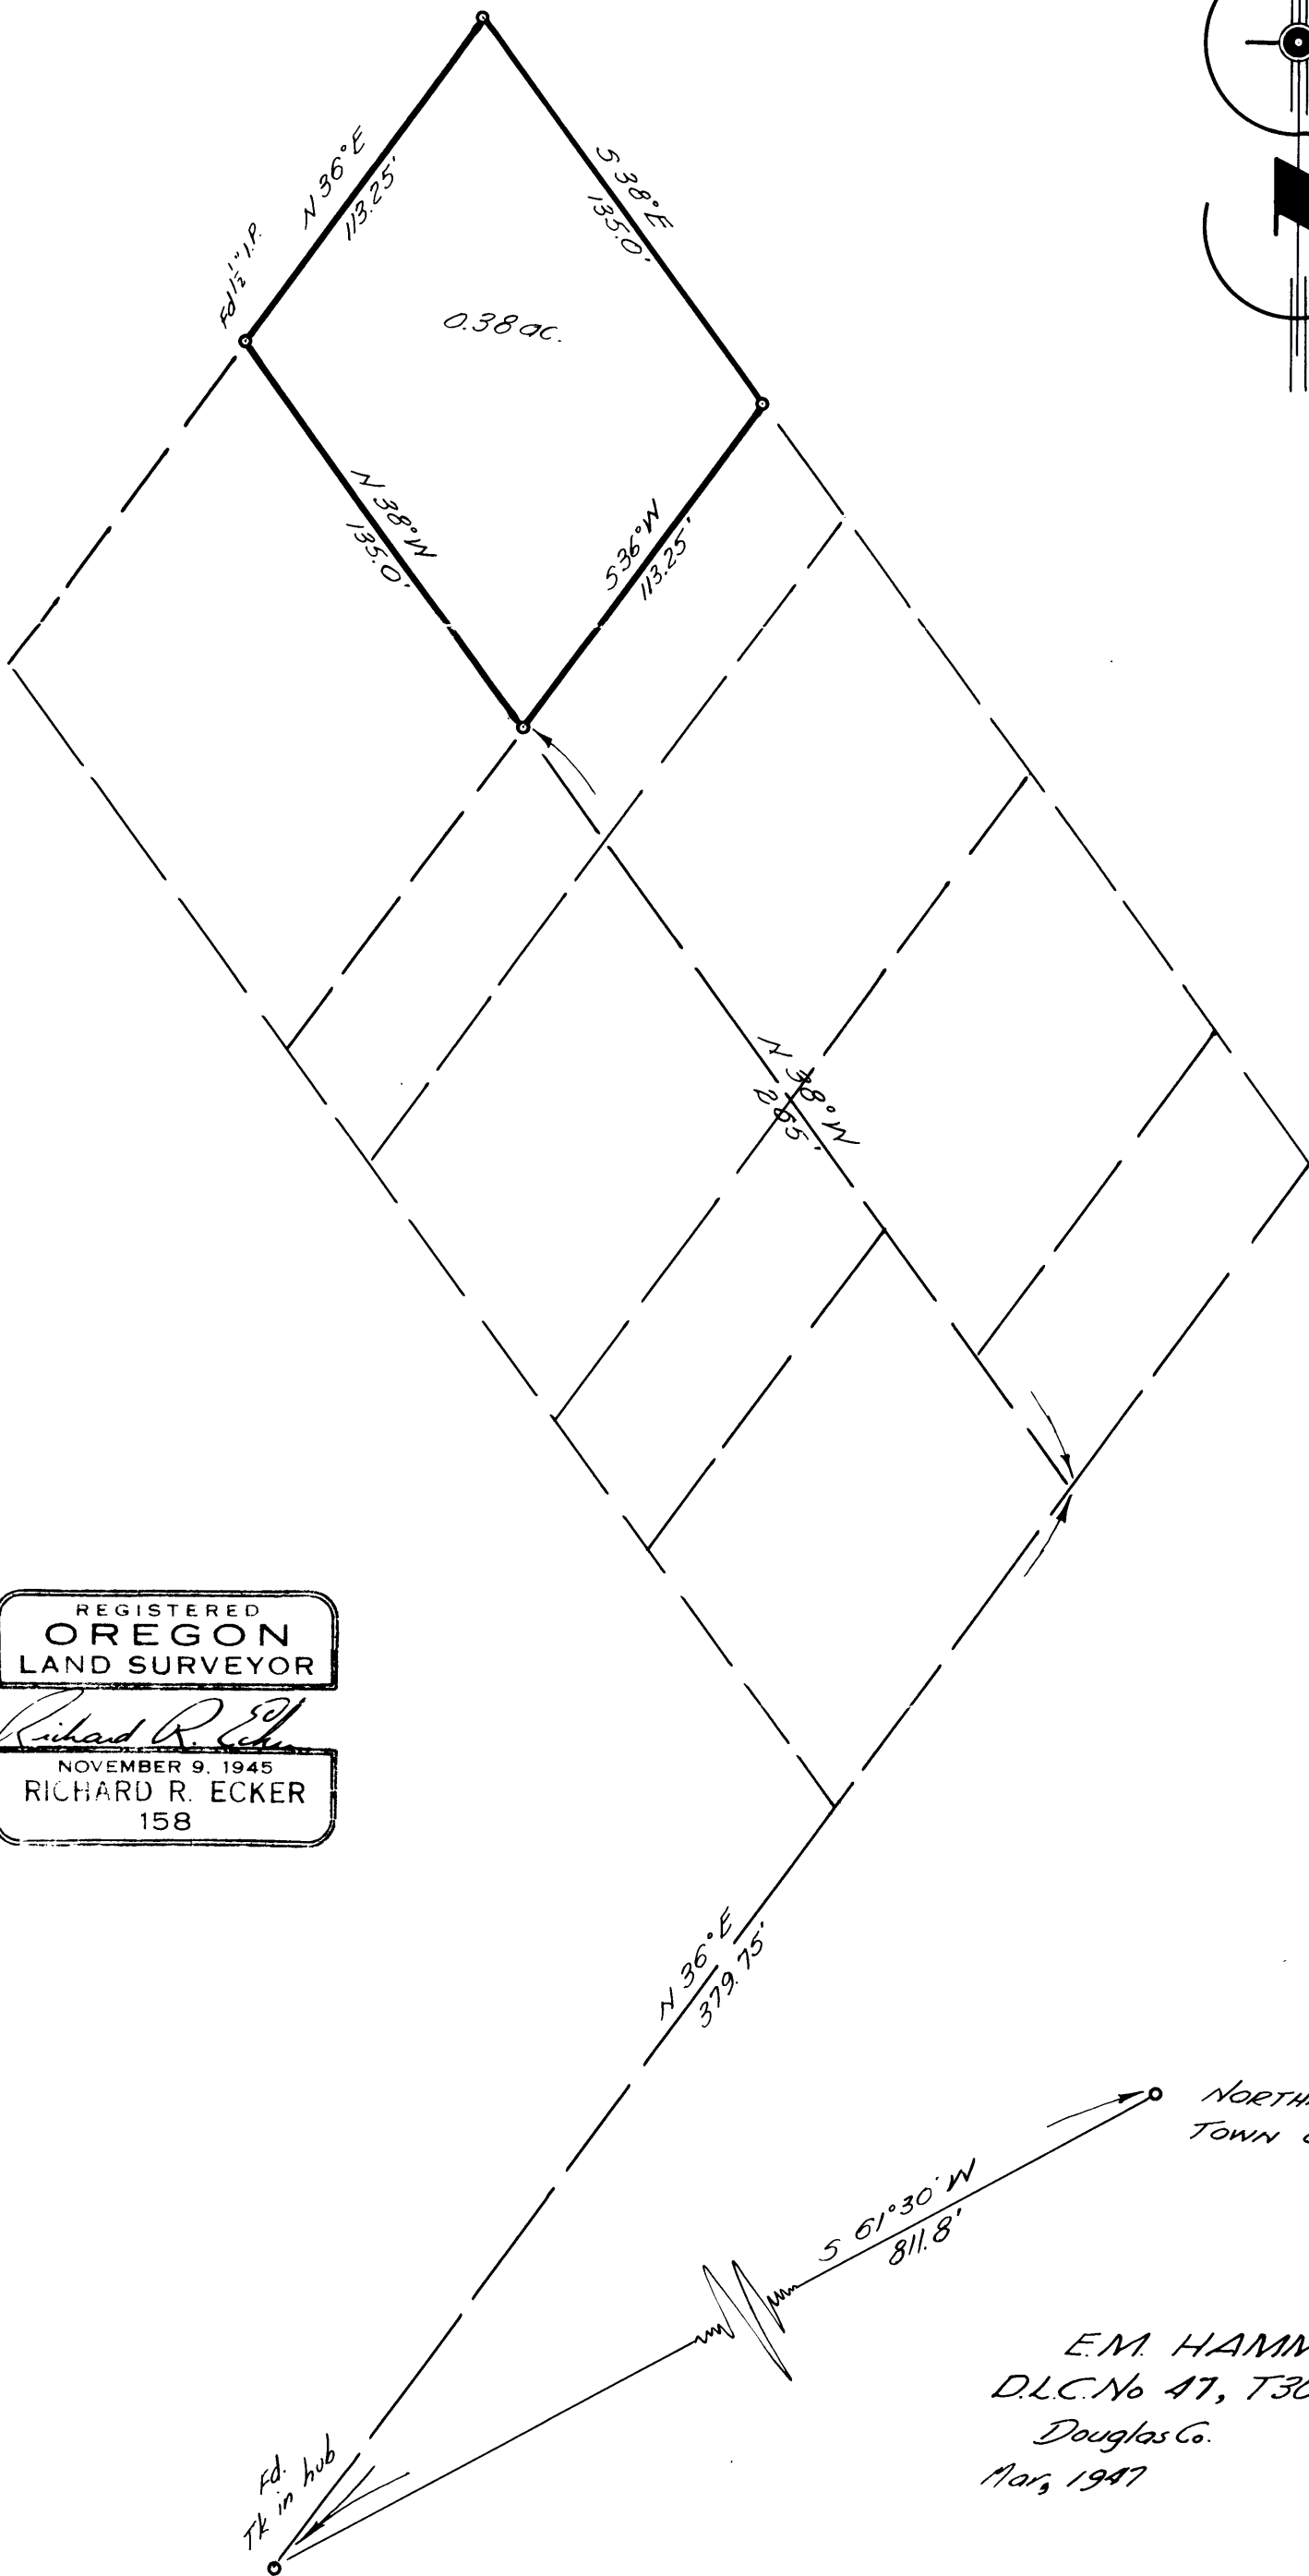


COUNTY SURVEYORS FILE DATA
DO NOT REMOVE FROM FILE

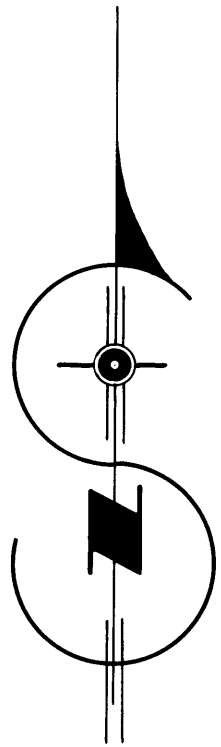

REGISTERED
OREGON
LAND SURVEYOR

Richard R. Ecker

NOVEMBER 9, 1945
RICHARD R. ECKER
158

E.M. HAMMERSLEY
D.L.C. No 47, T305, R6W, W.M.
Douglas Co. Oregon
Mar, 1947 Scale: 1" = 50'

CS FILE FOLDER

CONTAINS

MORE

INFORMATION