

COUNTY SURVEYORS FILE DATA

DO NOT REMOVE FROM OFFICE

MAP OF


PROPERTY OF ART HAGQUIST

SEC. 22, TWP. 27S, R. 6W. W.M.


Scale: 1 inch = 50 ft.

FILED  
RECEIVED  
JUL 1

COUNTY SURVEYOR  
DICKENS COUNTY, ILL.

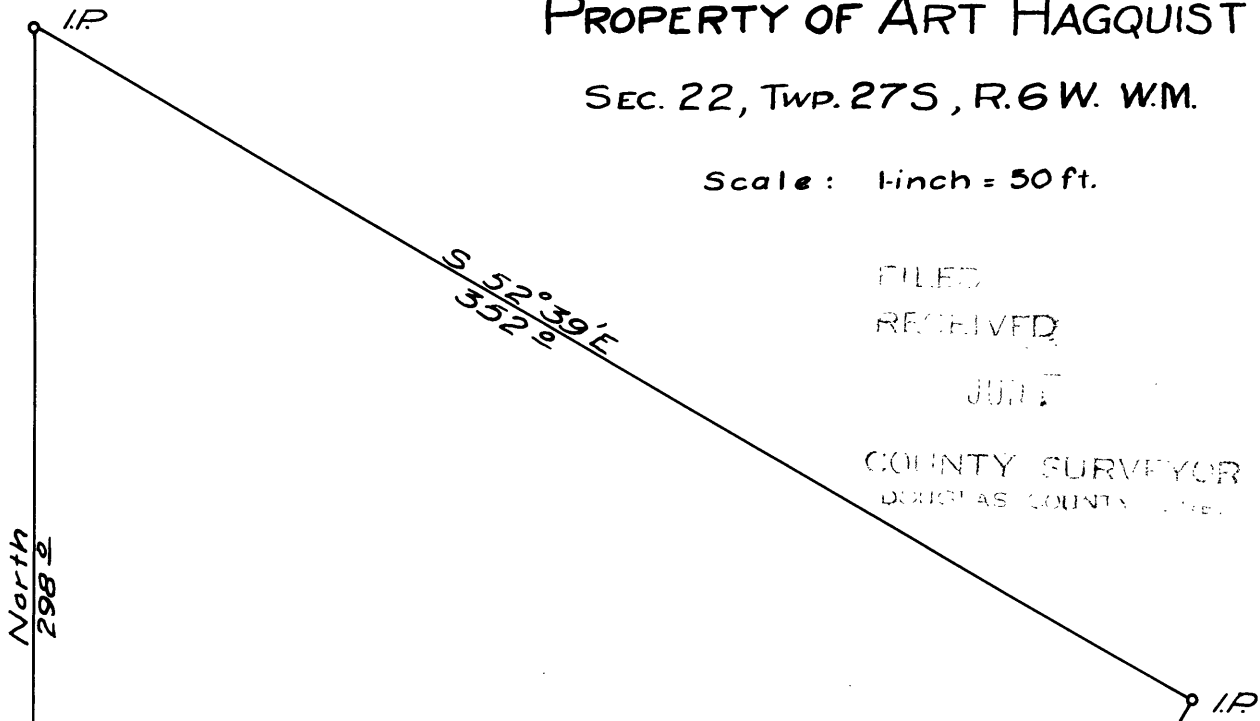

1.9 Acres

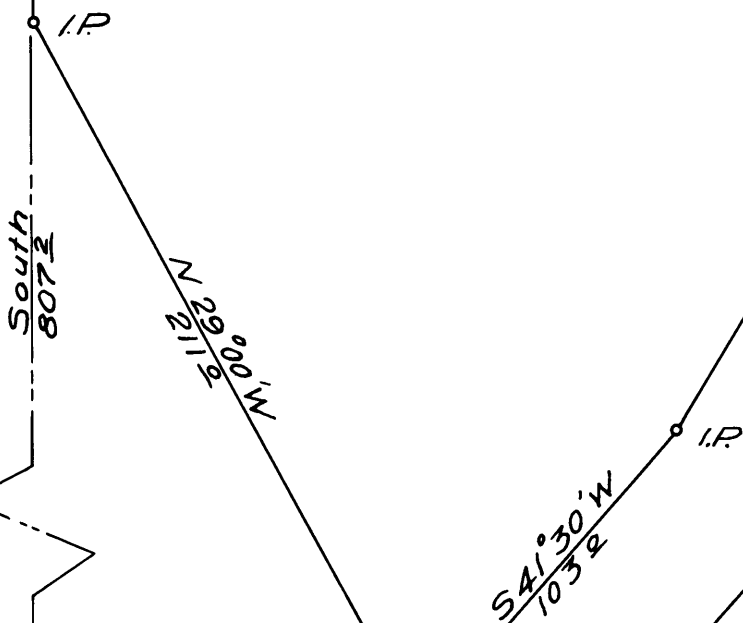

COUNTY ROAD No. 5

1/4 Cor. Secs. 22 & 27  
Twp 27 S, R 6 W. W.M.

