


MAP OF PROPERTY
CARL J. KITE ^{PLD} & ELEANOR B. LINN
 SEC. 21, T30S, R5W, W.M.
 SCALE = 1 inch = 200 feet

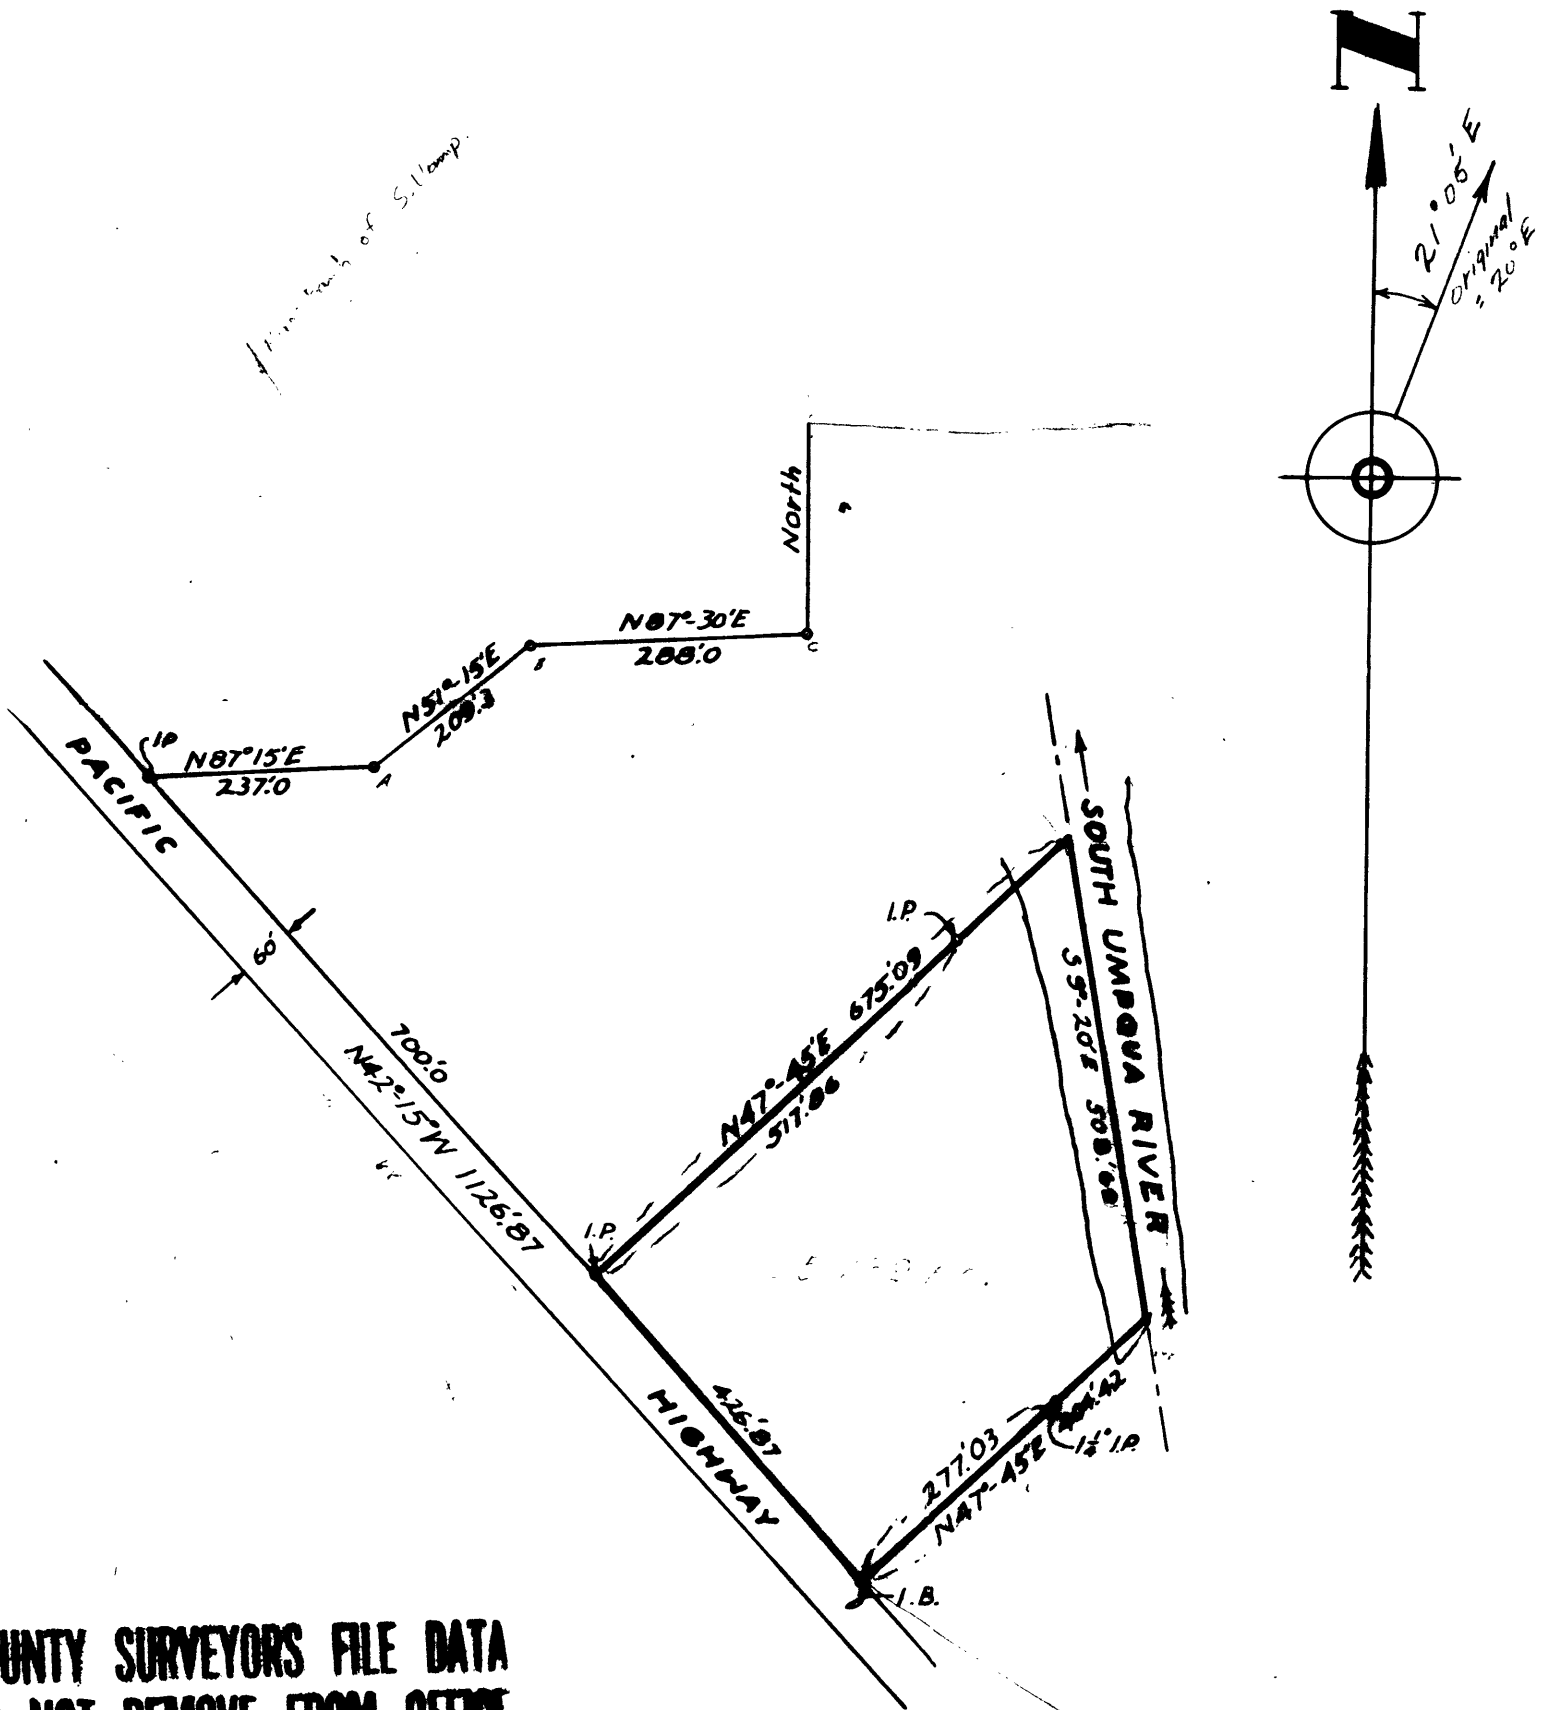

**COUNTY SURVEYORS FILE DATA
 DO NOT REMOVE FROM OFFICE**