


COUNTY SURVEYORS FILE DATA
DO NOT REMOVE FROM OFFICE

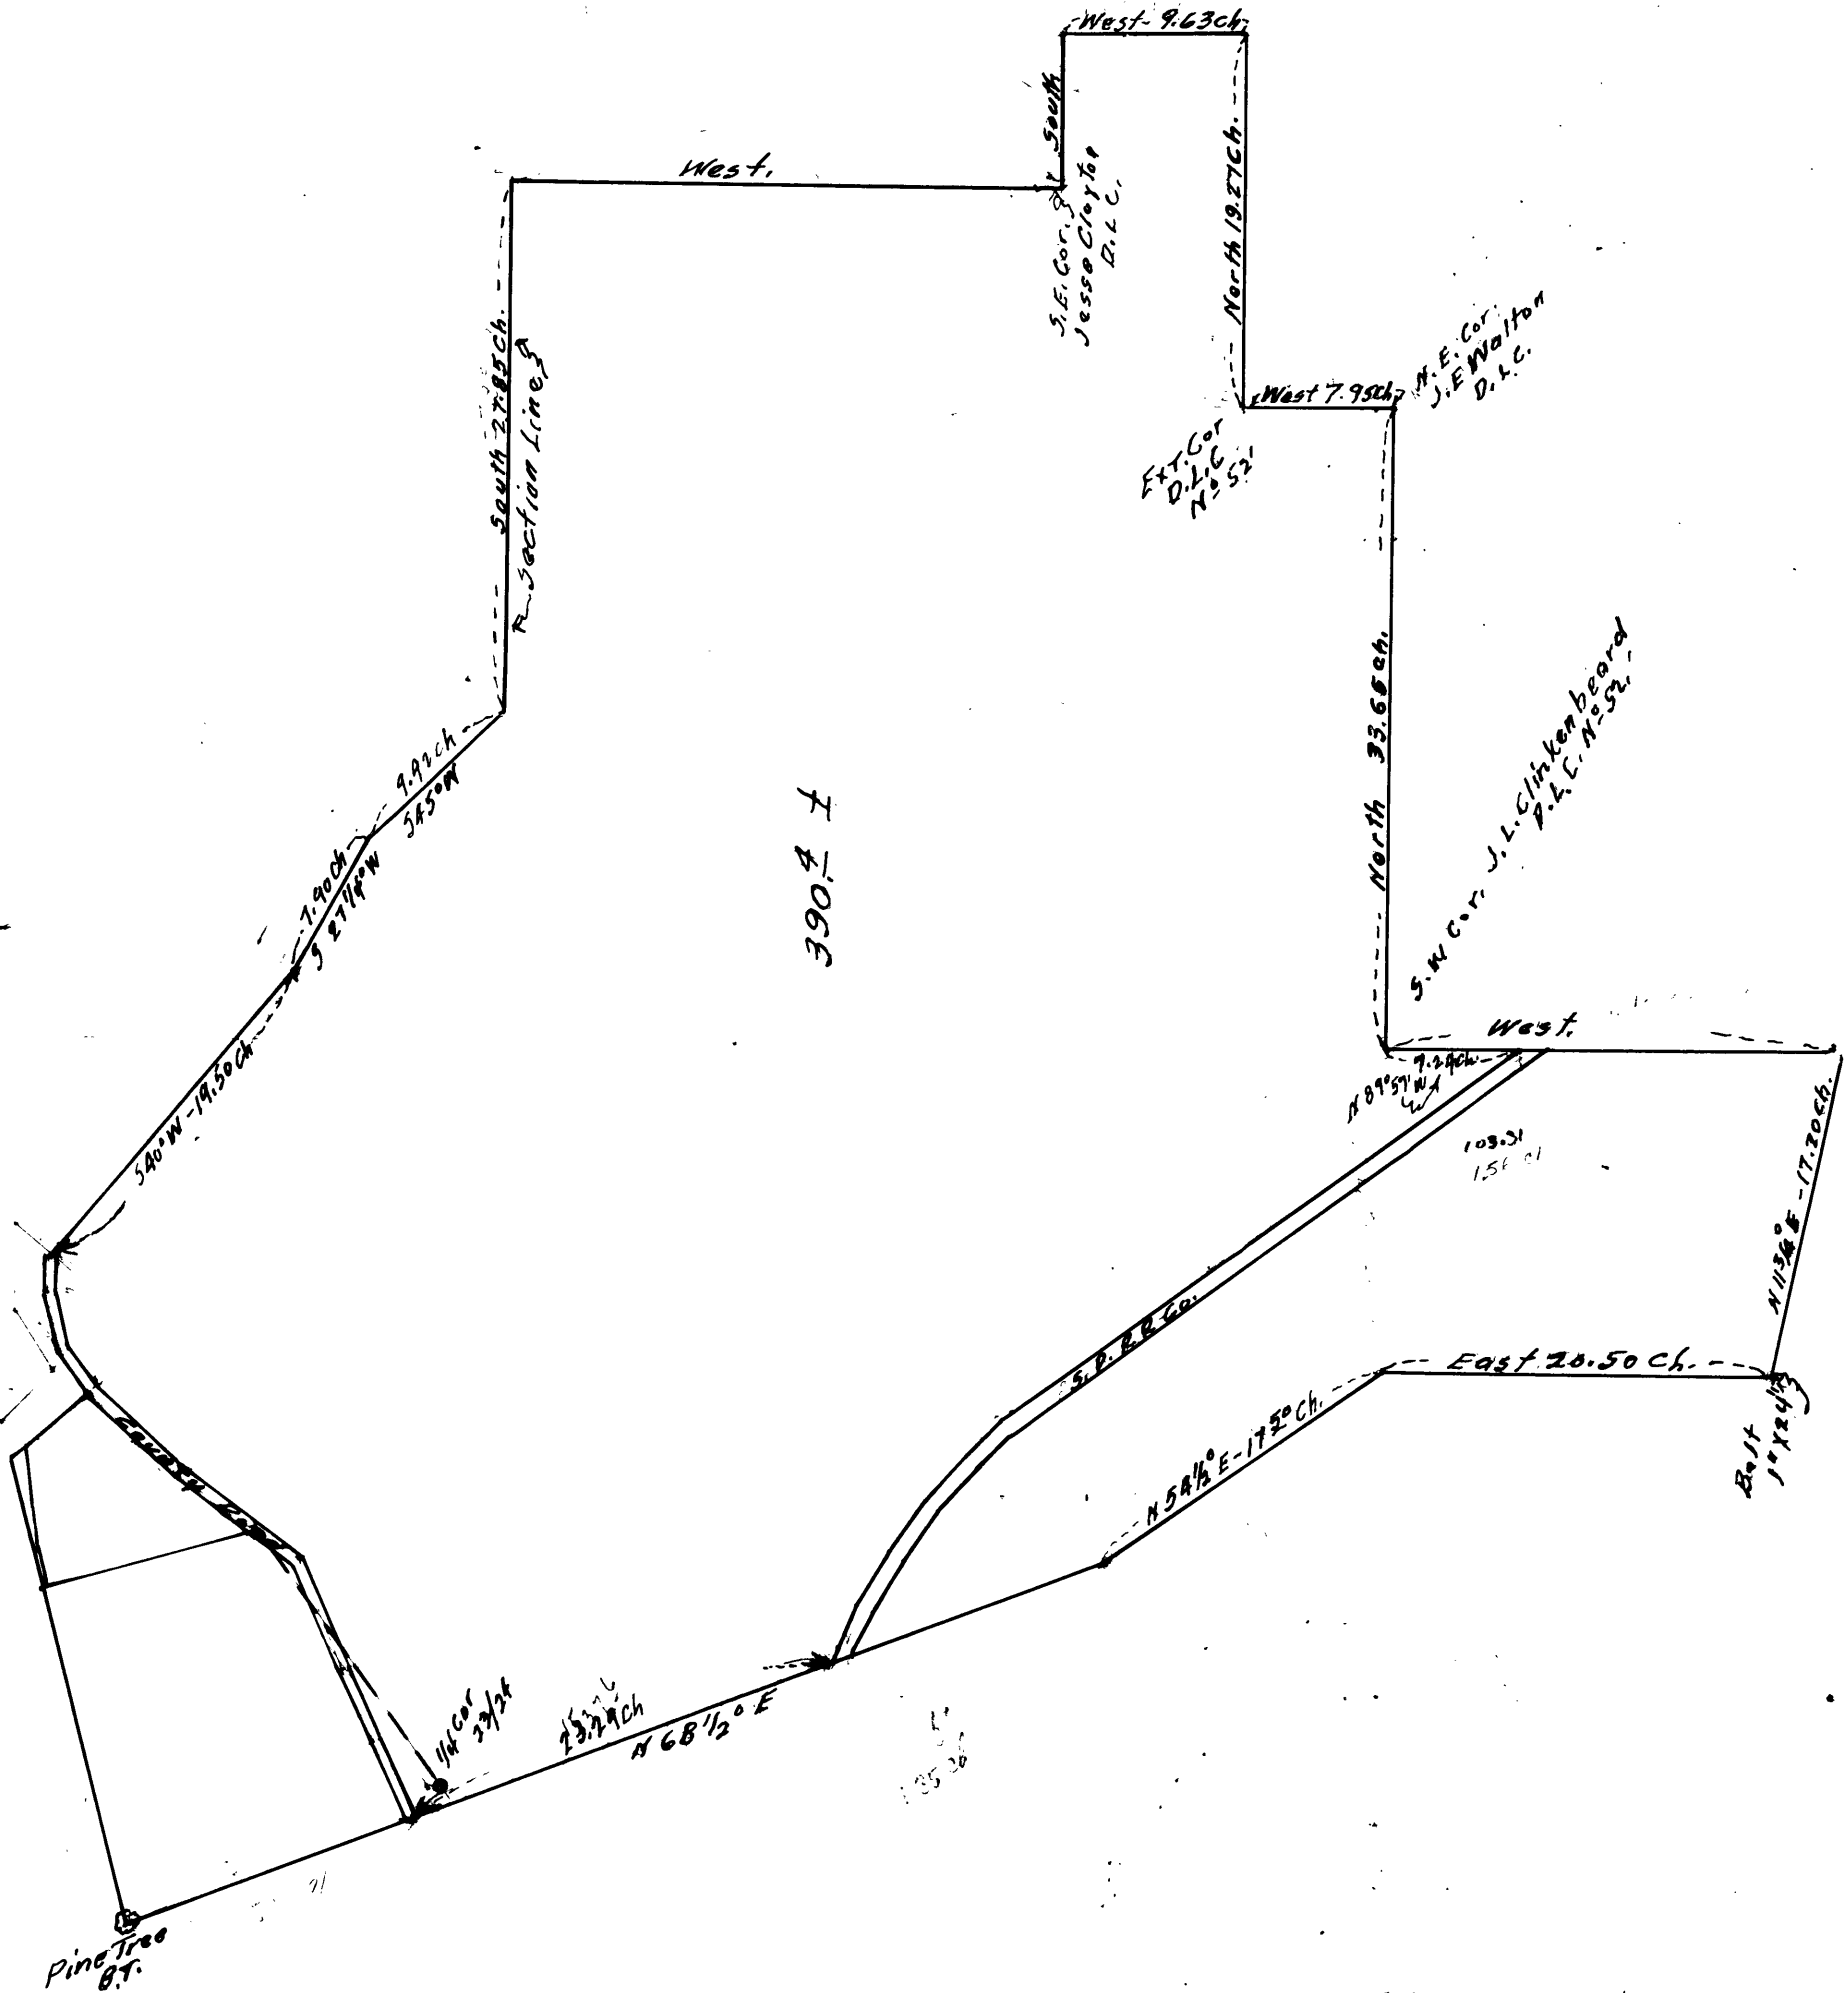

C.S. File No 40/123-2

40/123B