

COUNTY SURVEYORS FILE DATA  
DO NOT REMOVE FROM OFFICE



# MAP OF

# PROPERTY OF R. A. THURSTON

SEC. 22, T27S, R6W, WM

SCALE = 1 inch = 50 feet

RECEIVED  
COUNTY CLERK  
JAN 10 1919

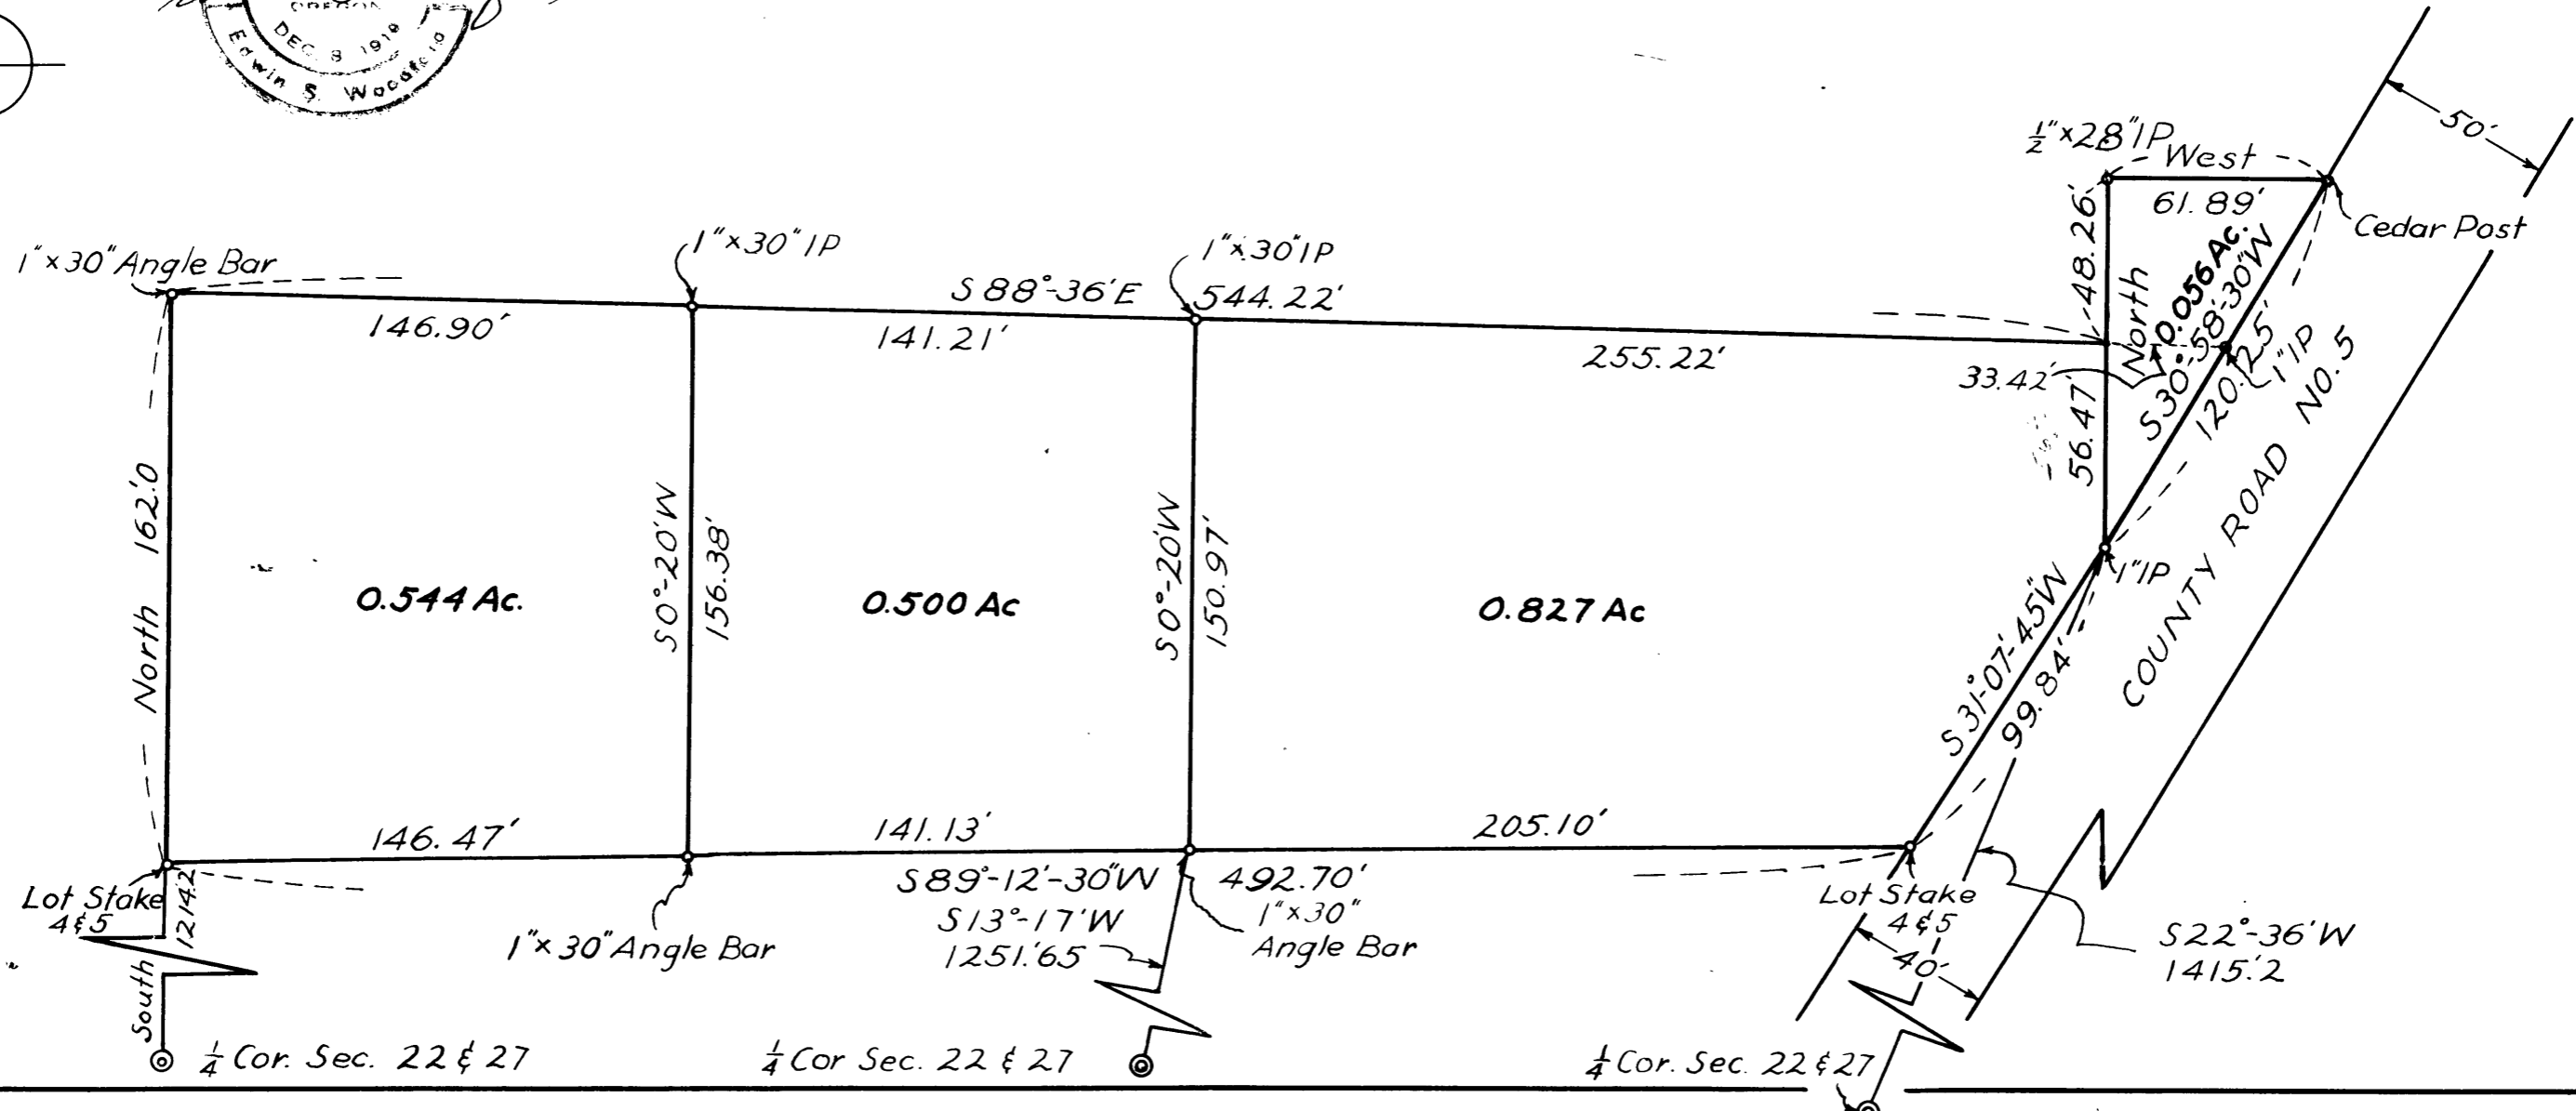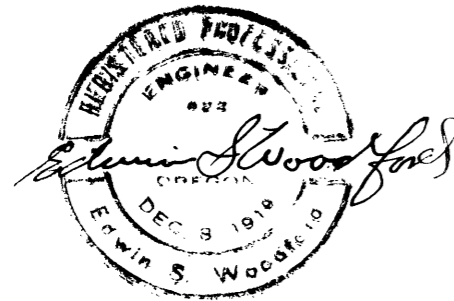

CS FILE FOLDER

CONTAINS

MORE

INFORMATION