


MAP OF

PROPERTY OF KEN ELLISON
LOT-1, PLAT B, N. CURRY ESTATE
SEC. 32, T26S, R6W, W.M.
SCALE - 1 inch = 100 feet

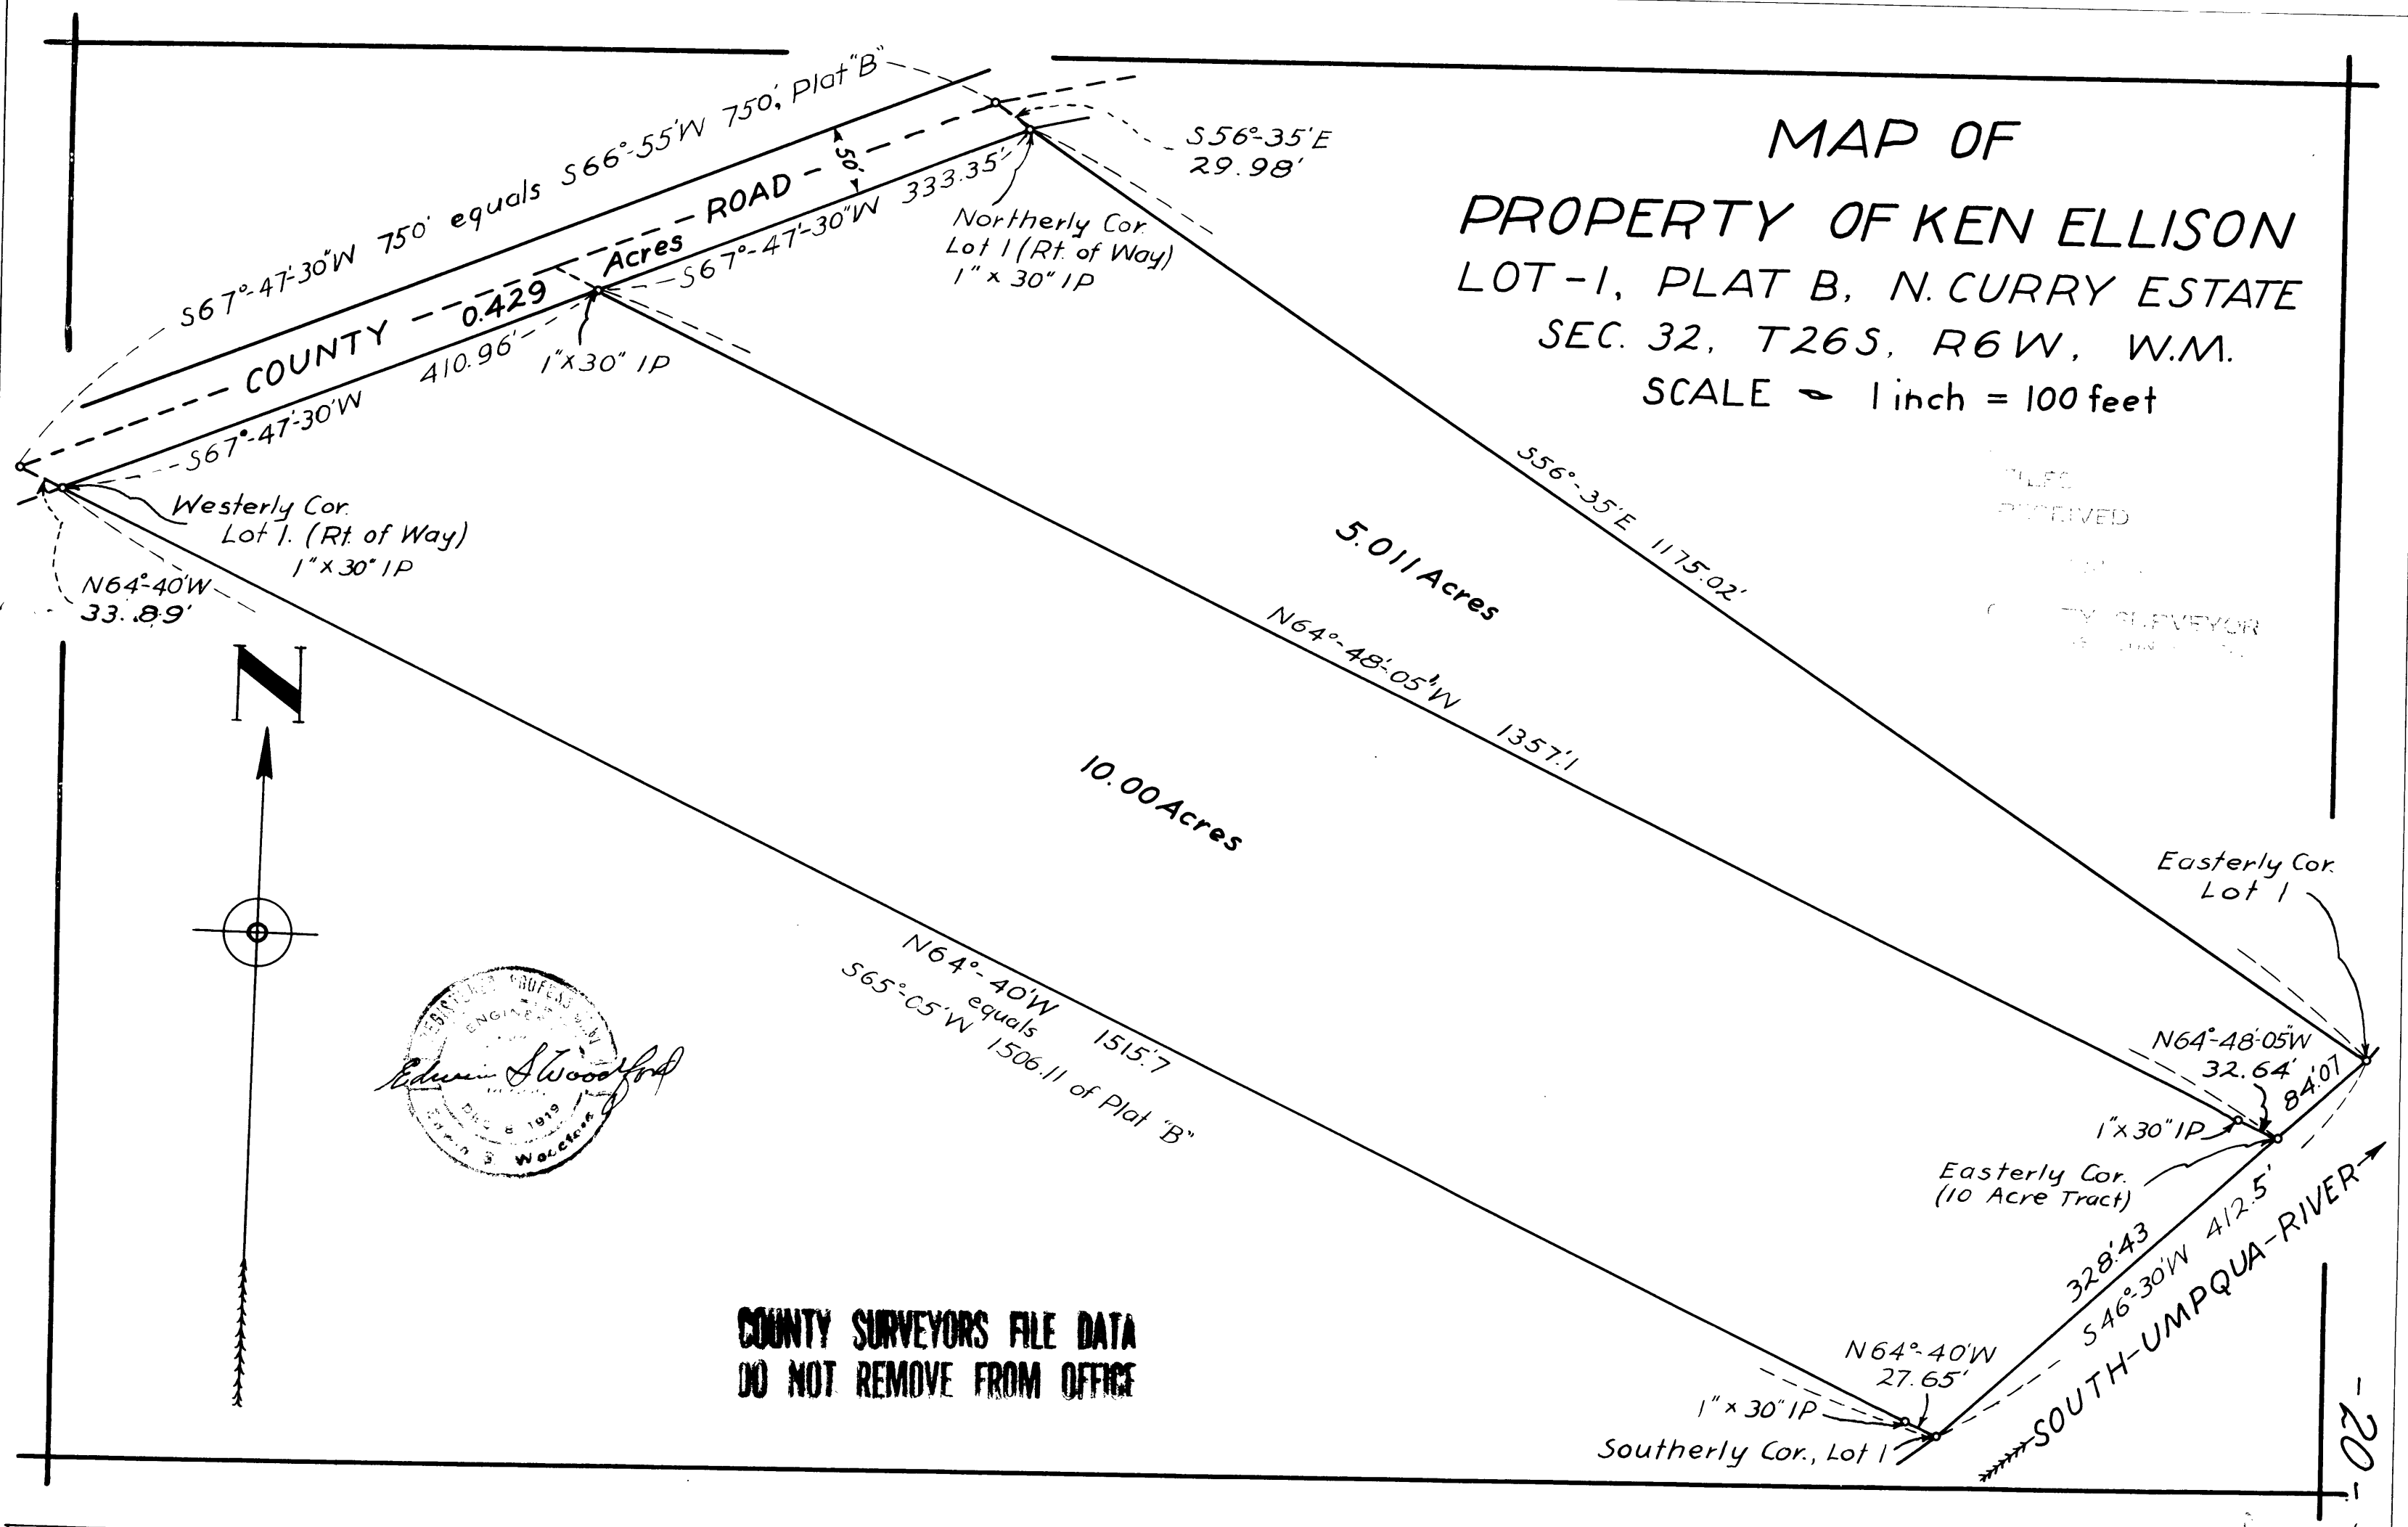

FILED
RECEIVED
COUNTY SURVEYOR



COUNTY SURVEYORS FILE DATA
DO NOT REMOVE FROM OFFICE

CS FILE FOLDER

CONTAINS

MORE

INFORMATION