


Copy
MAP

**COUNTY SURVEYORS FILE DATA
DO NOT REMOVE FROM OFFICE**

**OF
LOTS 15 and 16, BLOCK 2
NORTH PARK ADDITION TO ROSEBURG, OREGON
SURVEYED NOV. 1947**

SCALE - 1-inch = 30 ft.

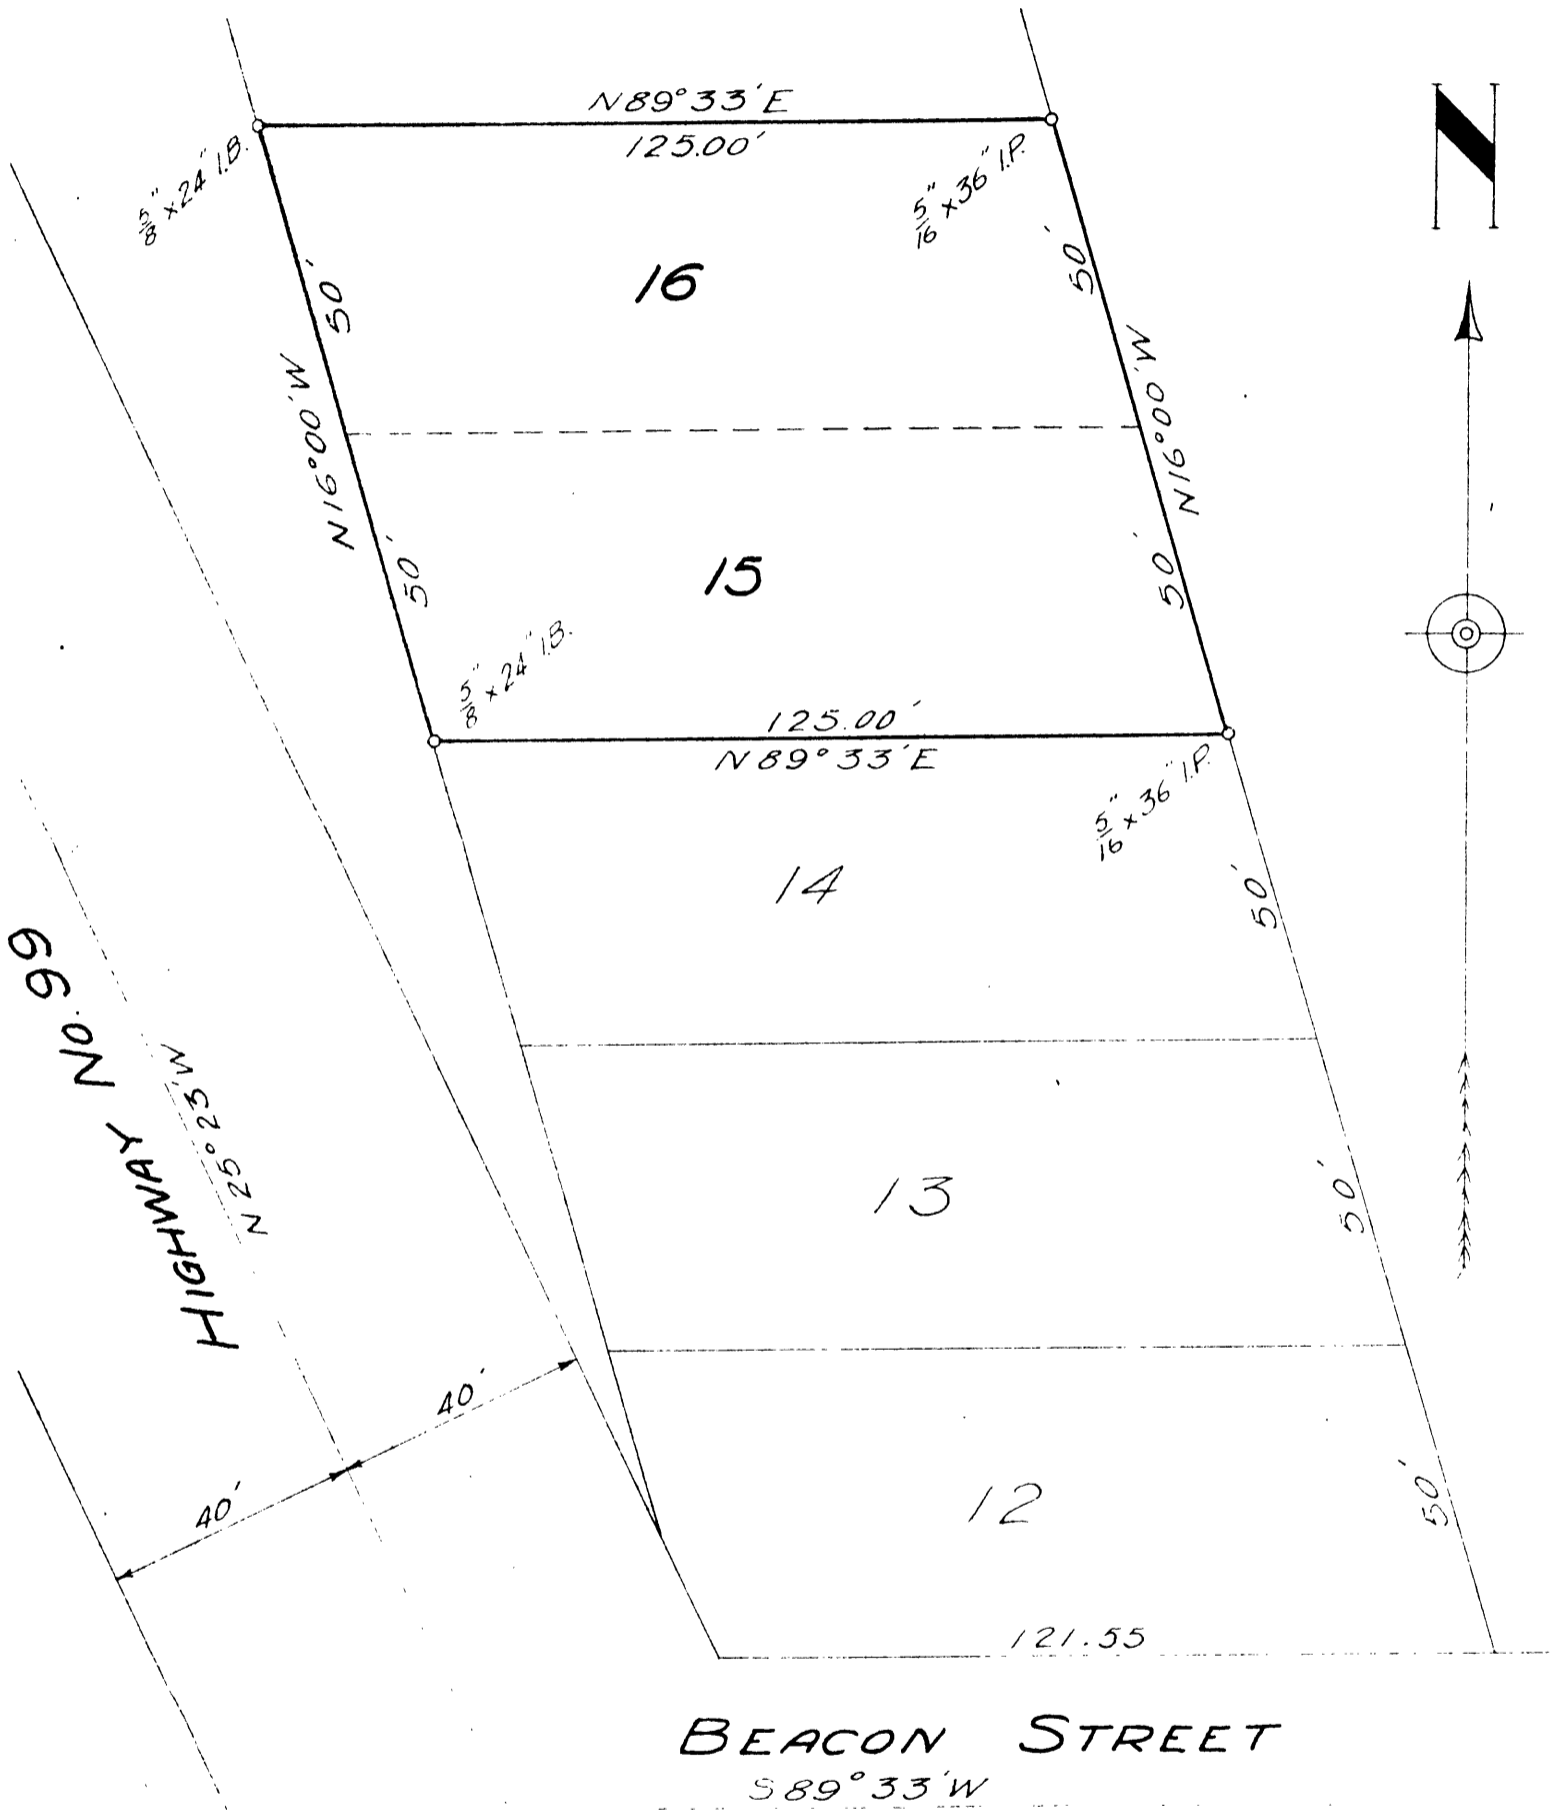

Edwin A Woodford

CS FILE FOLDER

CONTAINS

MORE

INFORMATION