


-96

COUNTY SURVEYORS FILE DATA
DO NOT REMOVE FROM OFFICE

FILED
RECEIVED

JUL 1919

COUNTY SURVEYOR
DOUGLAS COUNTY ORE.

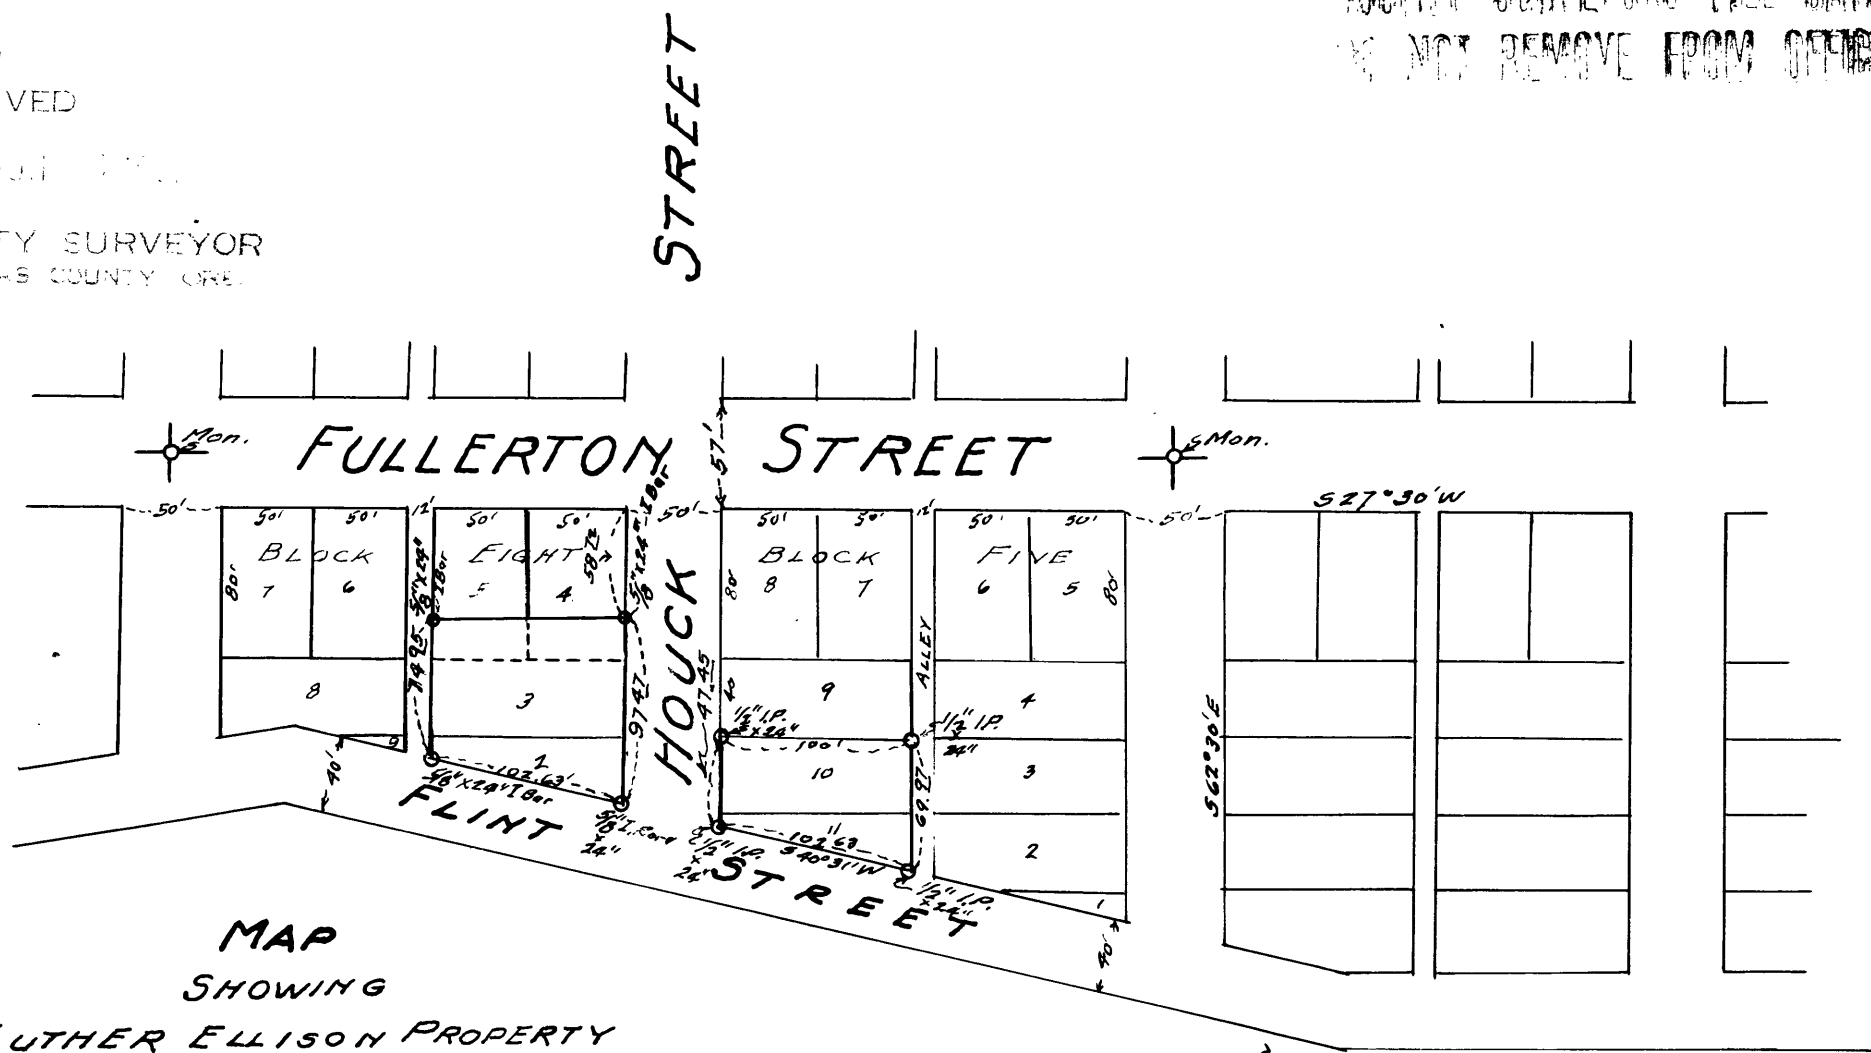

MAP
SHOWING
LUTHER ELLISON PROPERTY
IN
BLOCKS-5th & 8
OF
HAMILTON ADDITION
TO
CITY OF ROSEBURG OREGON
Scale-1"=100'



CS FILE FOLDER

CONTAINS

MORE

INFORMATION