
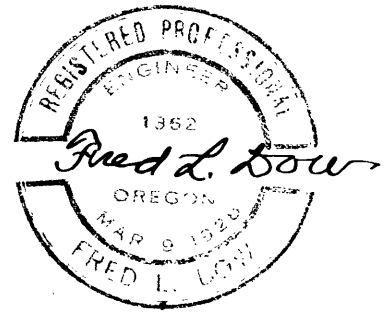


NE corner
Hugh Carlsen DLC #42
Sec. 19 T.29S.R.4W.W.M.

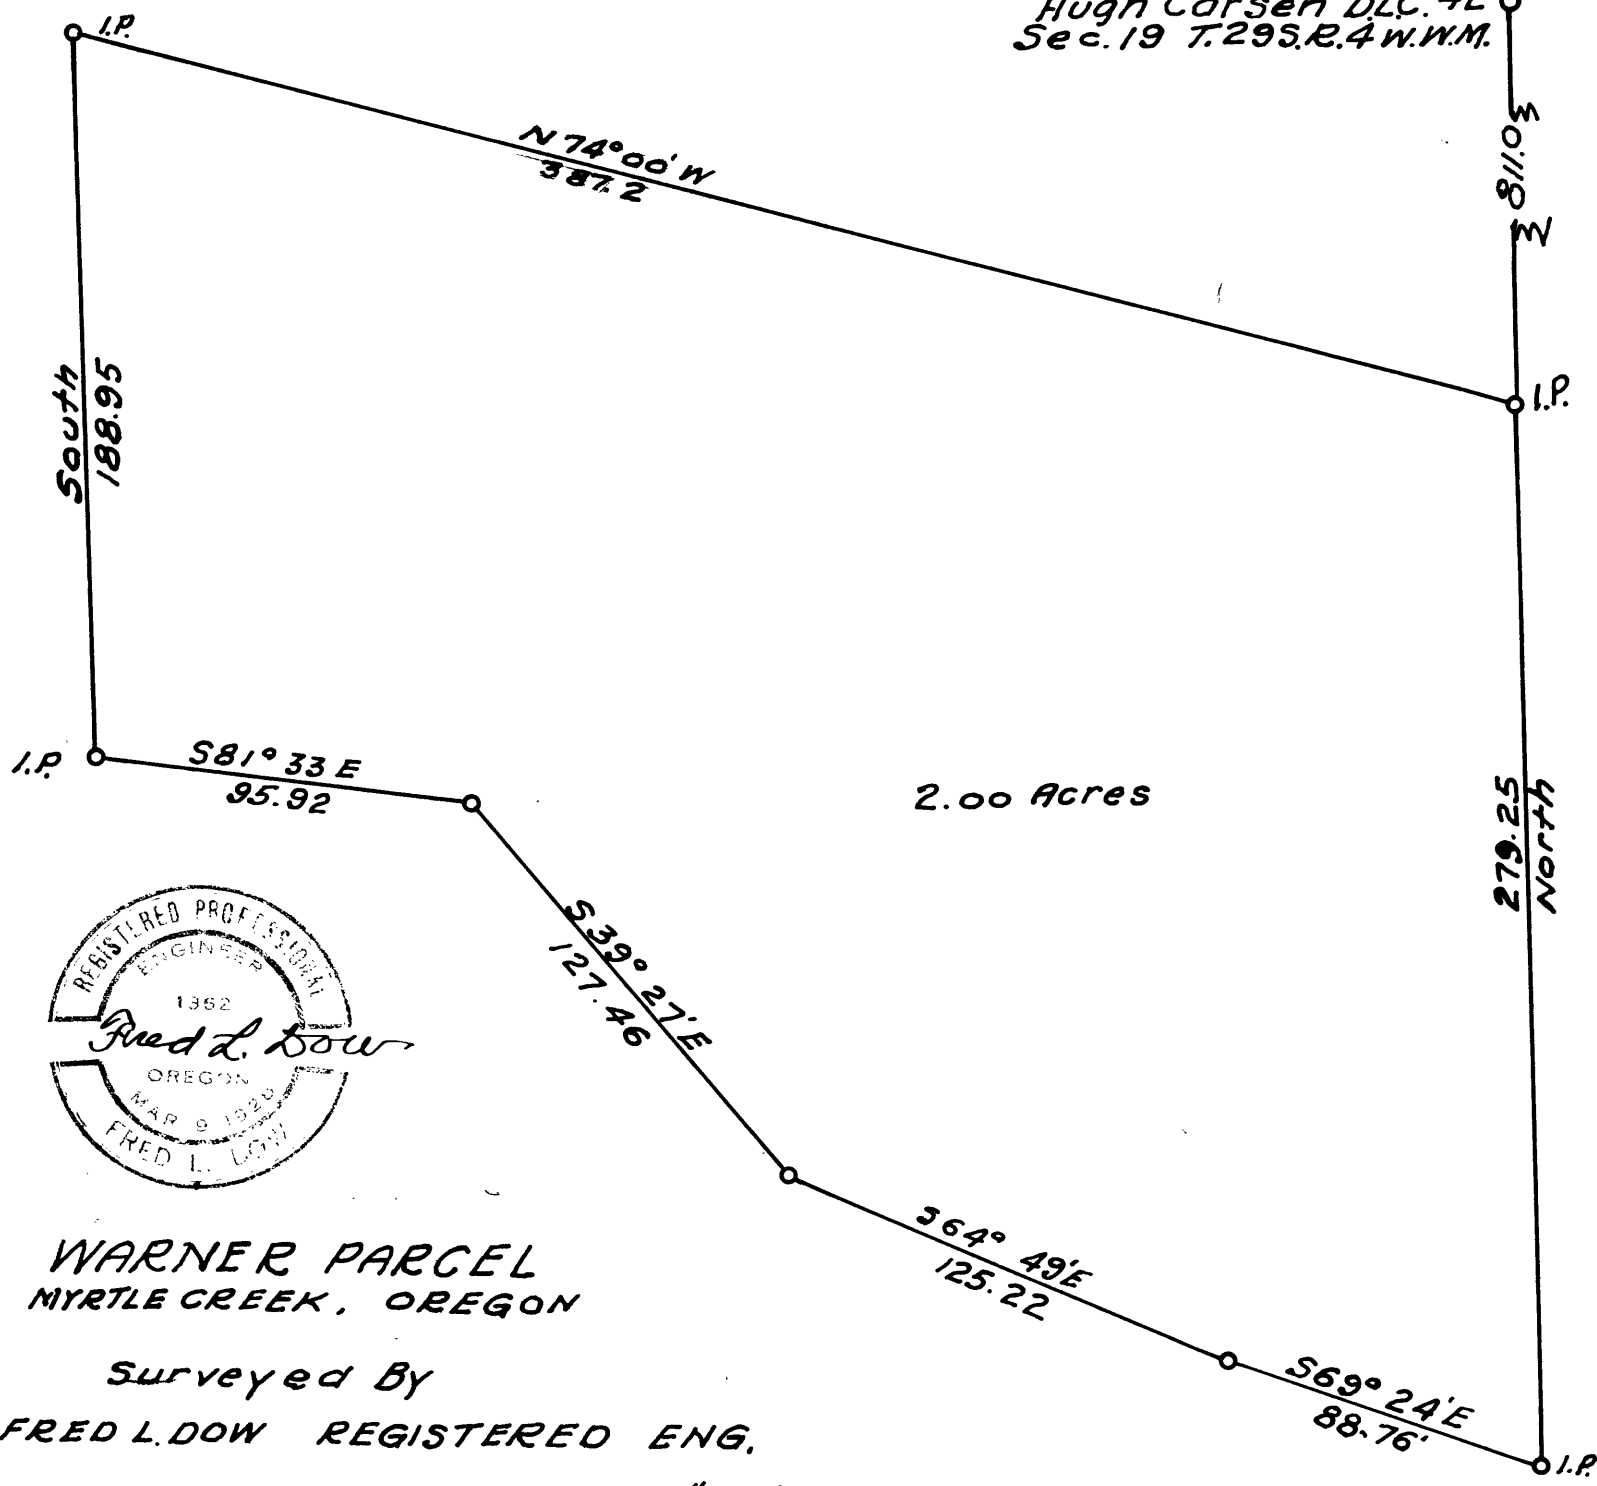

WARNER PARCEL
MYRTLE CREEK, OREGON

Surveyed By
FRED L. DOW REGISTERED ENG.
NOV. 1948 SCALE 1"=50'

COUNTY SURVEYORS FILE DATA
DO NOT REMOVE FROM OFFICE

c.s. 40/154

CS FILE FOLDER

CONTAINS

MORE

INFORMATION