


SURVEY OF LOTS
1 & 13 TO 17 INCLUSIVE
AMENDED PLAT 'O'
BLOCK 18
SUTHERLIN LAND
E WATER CO.
SCALE 1"=100 FT.

○ IRON ROD MARKERS SET.

COUNTY SURVEYORS FILE DATA
DO NOT REMOVE FROM OFFICE

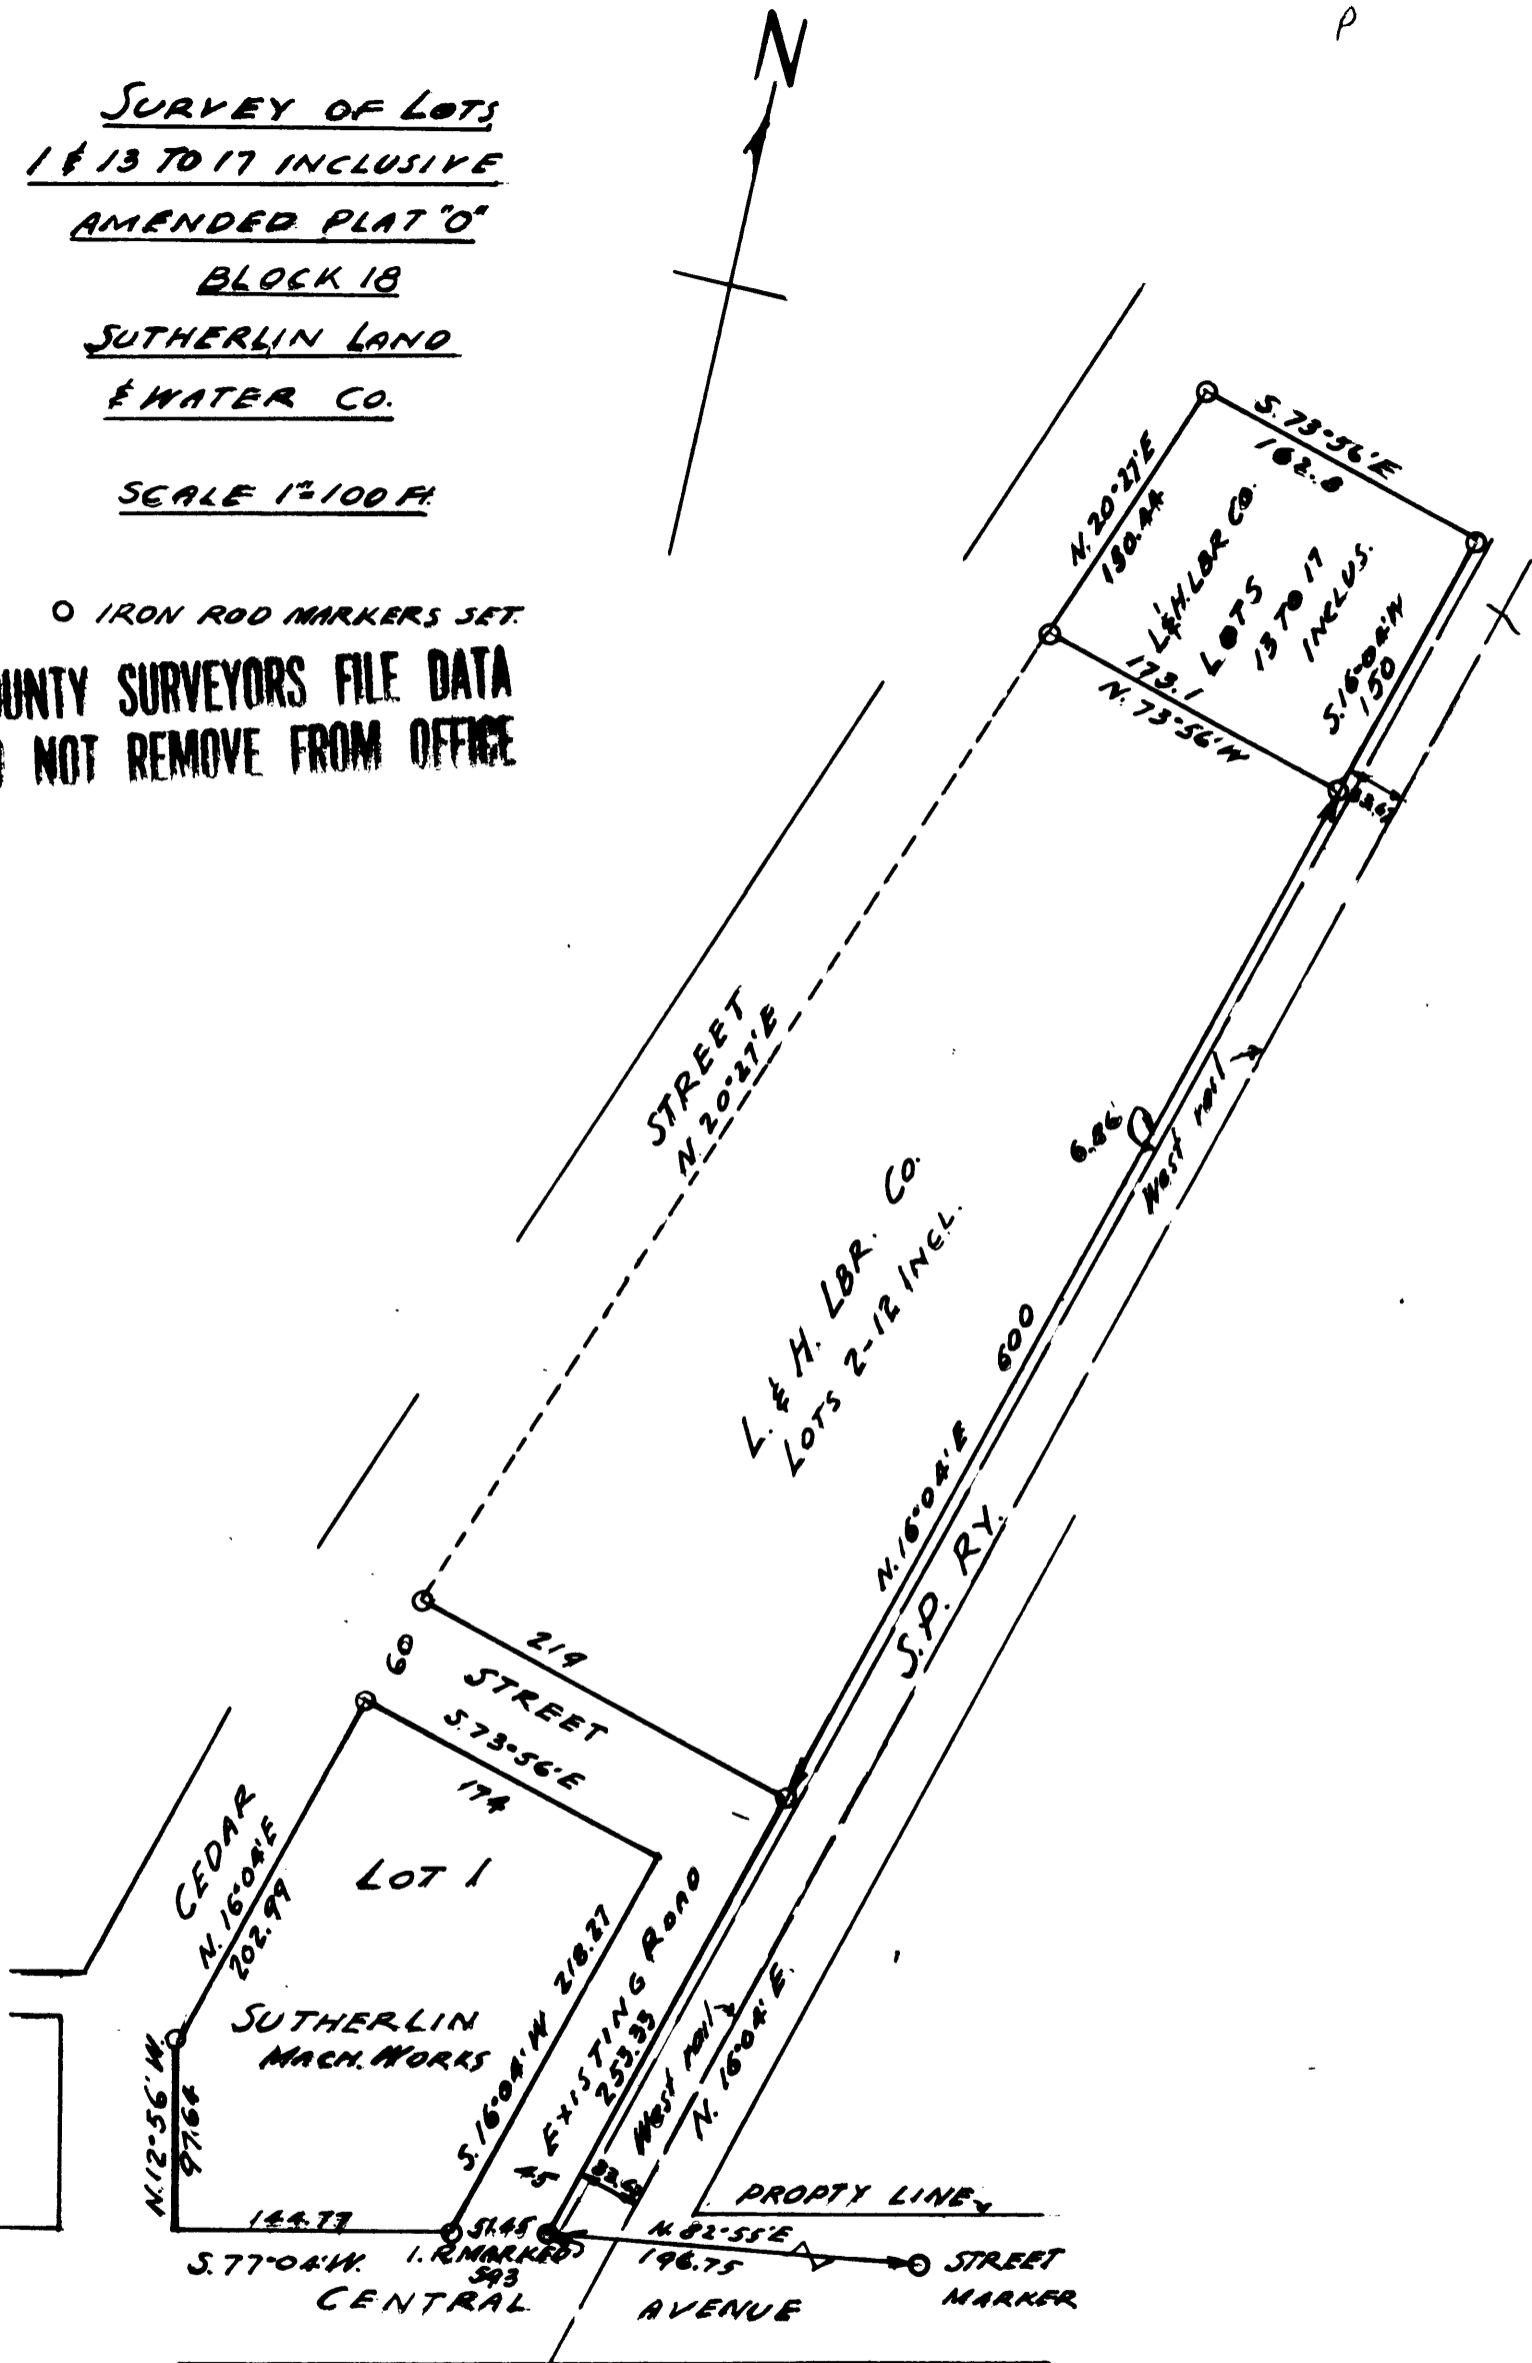

SURVEYED MAY 1940
 J. H. E. Jones
 Registered Prof. Engr.