


COUNTY SURVEYORS FILE DATA
DO NOT REMOVE FROM OFFICE

PREPARED FOR

FRANCIS M. LYNN

BY JOHN H. MARKHAM, JR. SCALE 1" = 100'

LOT 8, SECTION 10 T.30S. R.4W. W.M. OREGON

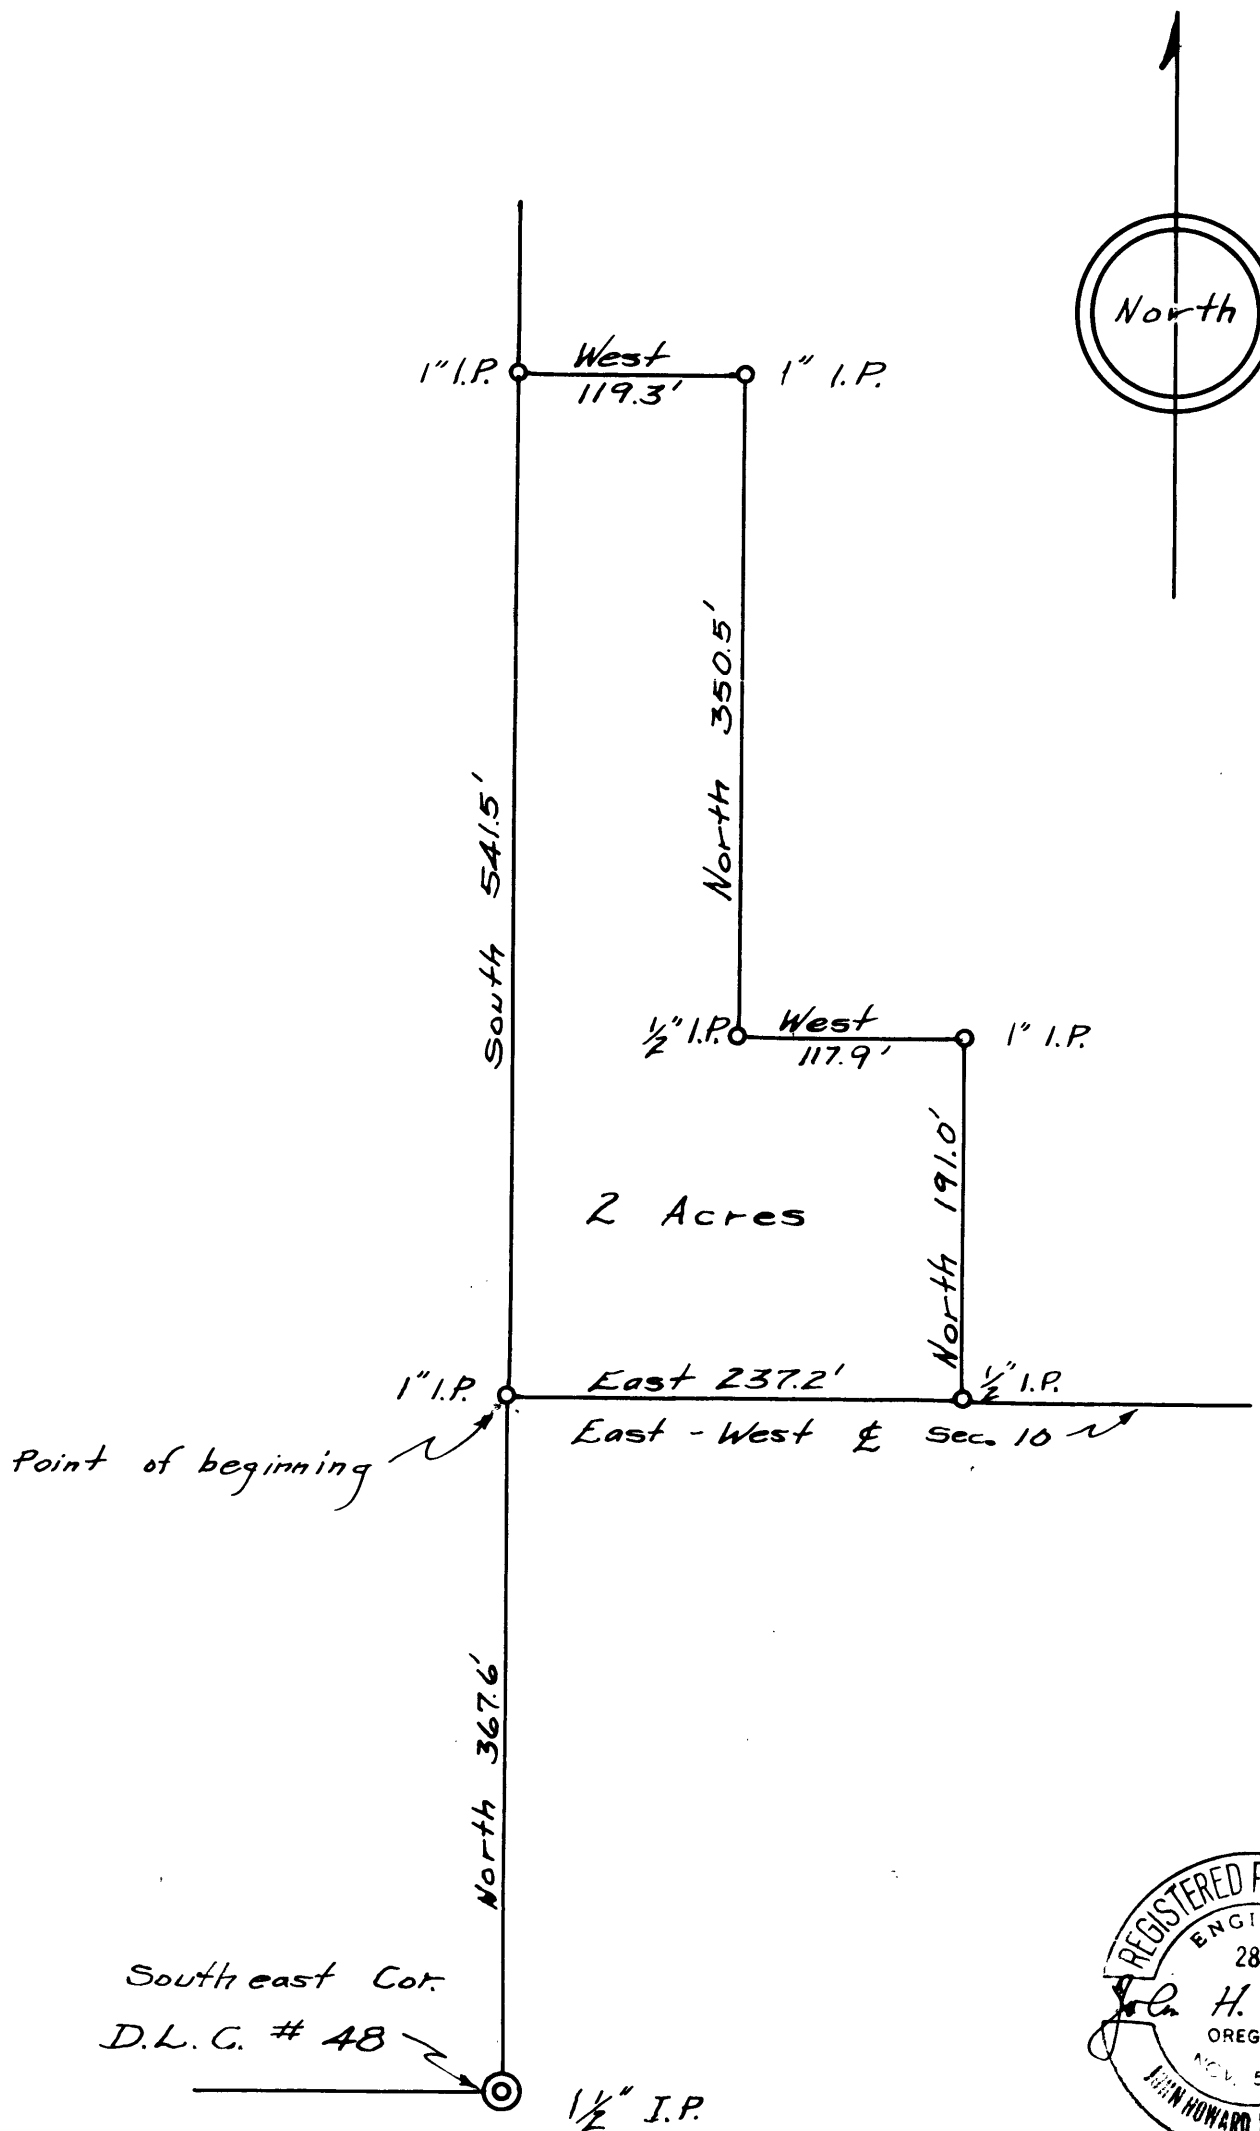

John H. Markham, Jr. 2-1-49