
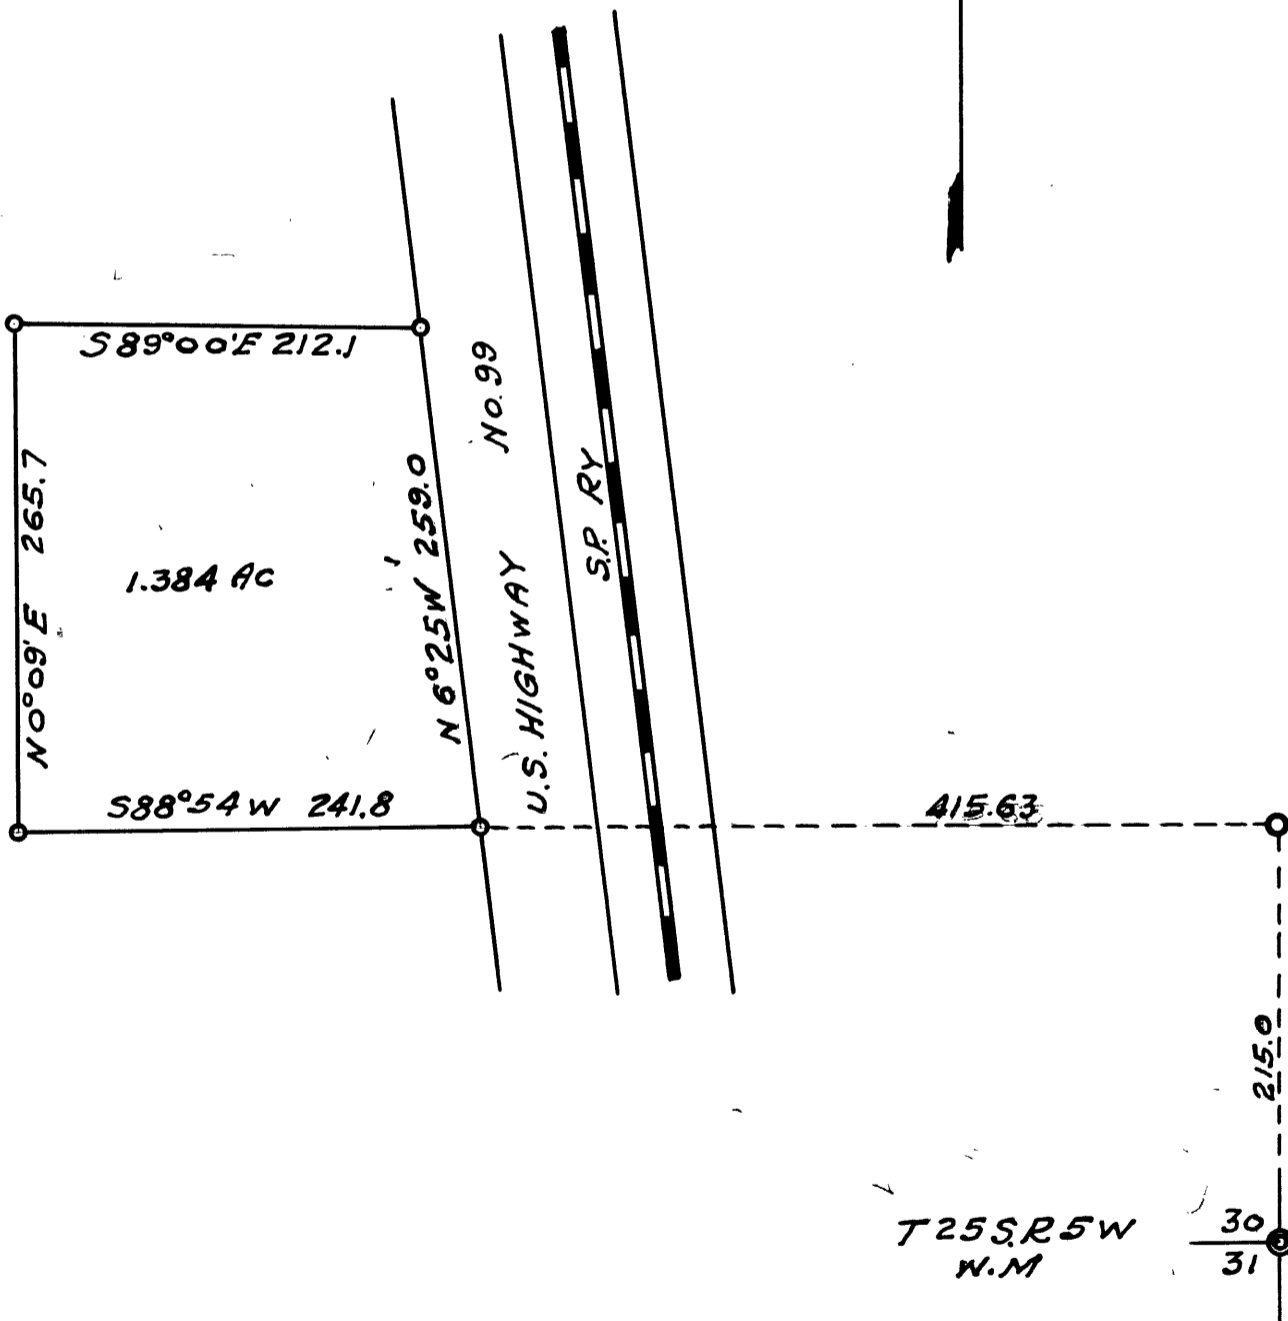


COUNTY SURVEYORS FILE DATA  
DO NOT REMOVE FROM OFFICE

PROPERTY SURVEY  
FOR BOB FOSTER  
IN SECTION 30 T.25 S. R.5 W.  
SCALE 1"=100' SURVEY BY  
MARCH 1949 FRED L. DOW  
REG. ENG

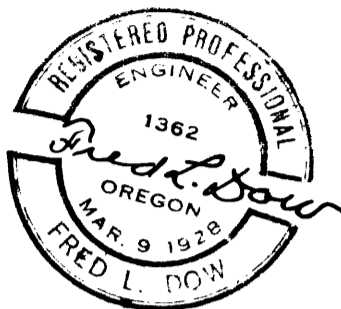

(1)