


GLEN. A. WELLMAN PROPERTY
RIVERSIDE ADDITION BLK. 14
Scale 1"=40'-0"
April 13, 1949



COUNTY SURVEYORS FILE DATA
DO NOT REMOVE FROM OFFICE

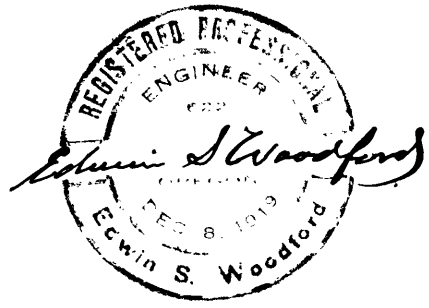