


Beginning Point
Lat. 24146' N
Dep. 2245.0 E
SE Corner DLc 42

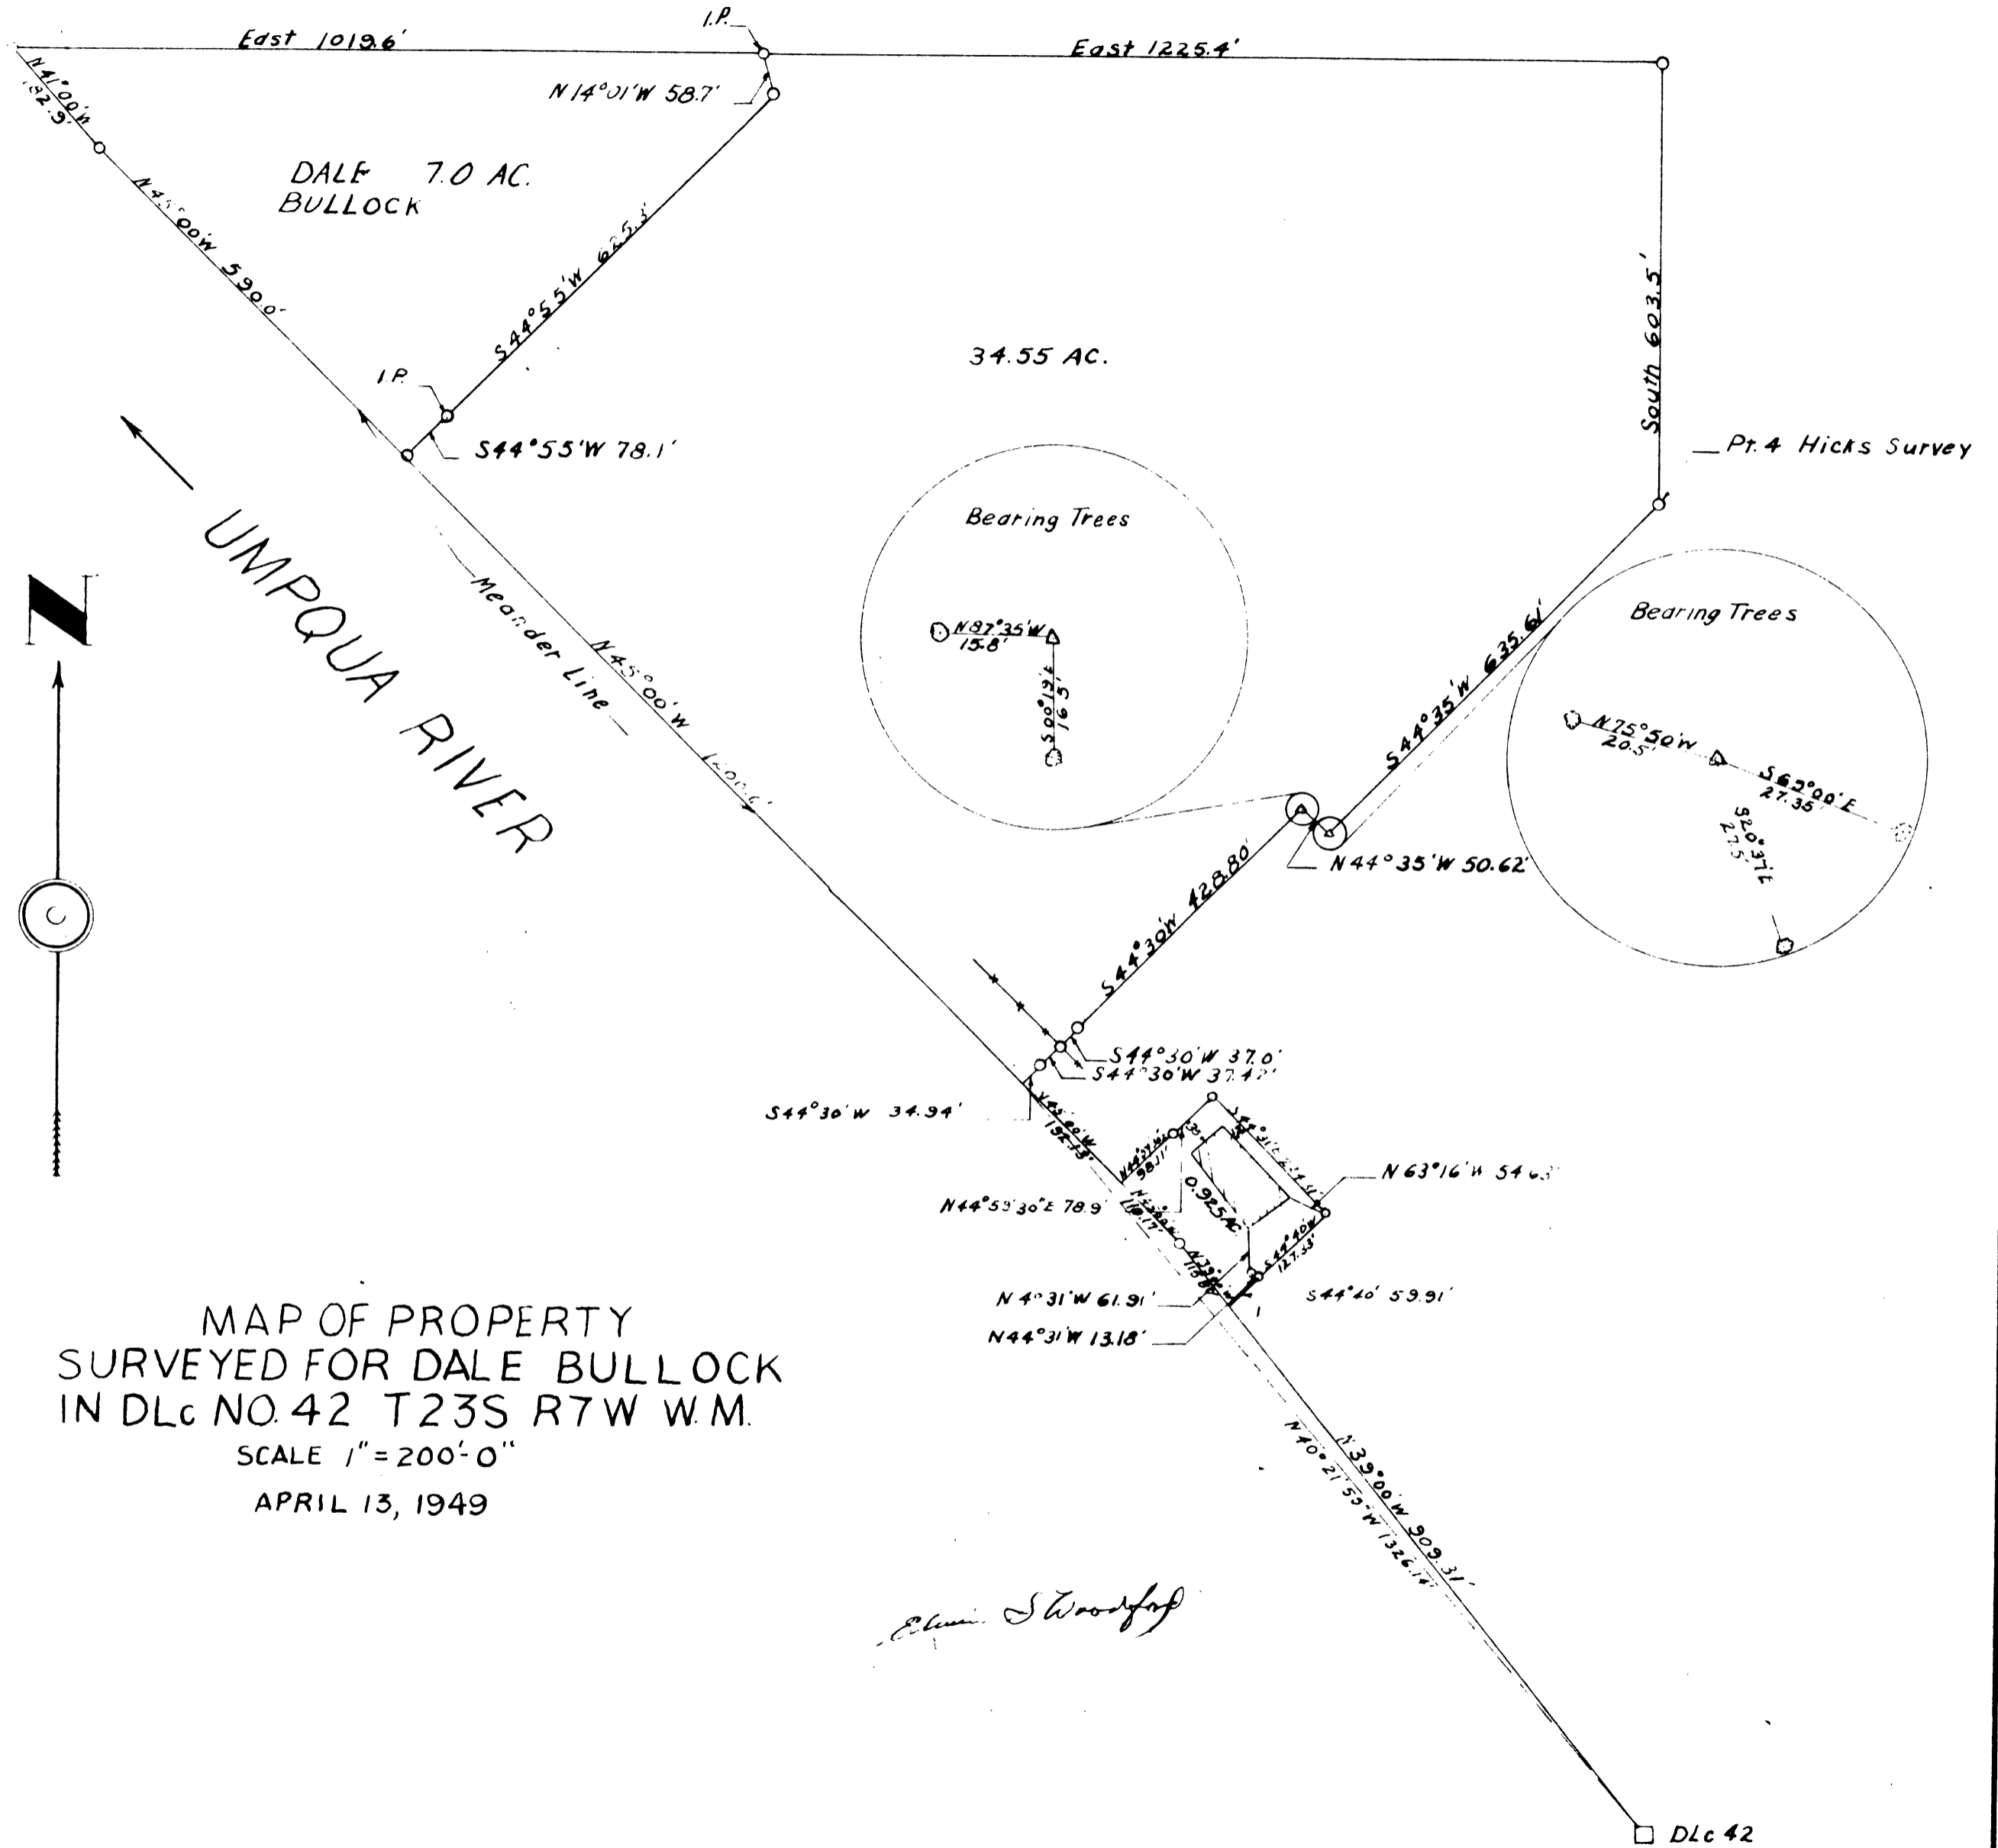

MAP OF PROPERTY
SURVEYED FOR DALE BULLOCK
IN DLc NO. 42 T23S R7W W.M.
SCALE 1" = 200'-0"
APRIL 13, 1949

E. J. Woodruff

CS FILE FOLDER

CONTAINS

MORE

INFORMATION