

7-25-51

Section Corner 5-6-7-8,
T30S, R4W, W.M. as det.
by O.B.T.s as follows.

- B.O. 26' diam. bears N65E 40.0' dist. remarked S.C. 56, B.T.
- B.O. 10" diam. bears S55E 56.0' dist. remarked S.C. 58, B.T.
- W.O. 22" diam. bears N88W, 40.0' dist. remarked S.C. 55, B.T.
- L.O. 8" diam. bears S52W 22' dist. mhd. S.C. 57, B.T.

At corner pt. set 1" x 30" I.P.
from which


- 1/4 cor. bears North 2610'
- 1/4 " " West 2540'
- 1/4 " " East 2695'

There is a fence running
East & West from corner.

OVER.

40/179⁴

Witness:
Geo. Vaughn

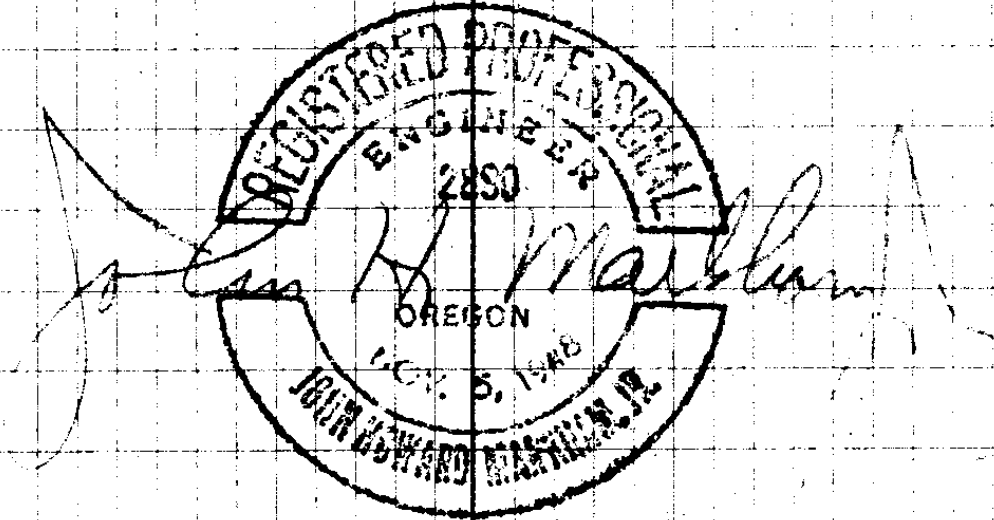

FILED
RECEIVED

JUL 27-1951

COUNTY SURVEYOR
DOUGLAS COUNTY, ORE.

Work done for Starna Lbr Co.