


# M. B. MORTON & W. P. BOOTZ

NORTH HALF SECTION 22 T30S R2W W.M.

COUNTY SURVEYORS FILE DATA  
DO NOT REMOVE FROM OFFICE

SCALE 1" = 50'

JUNE 1949

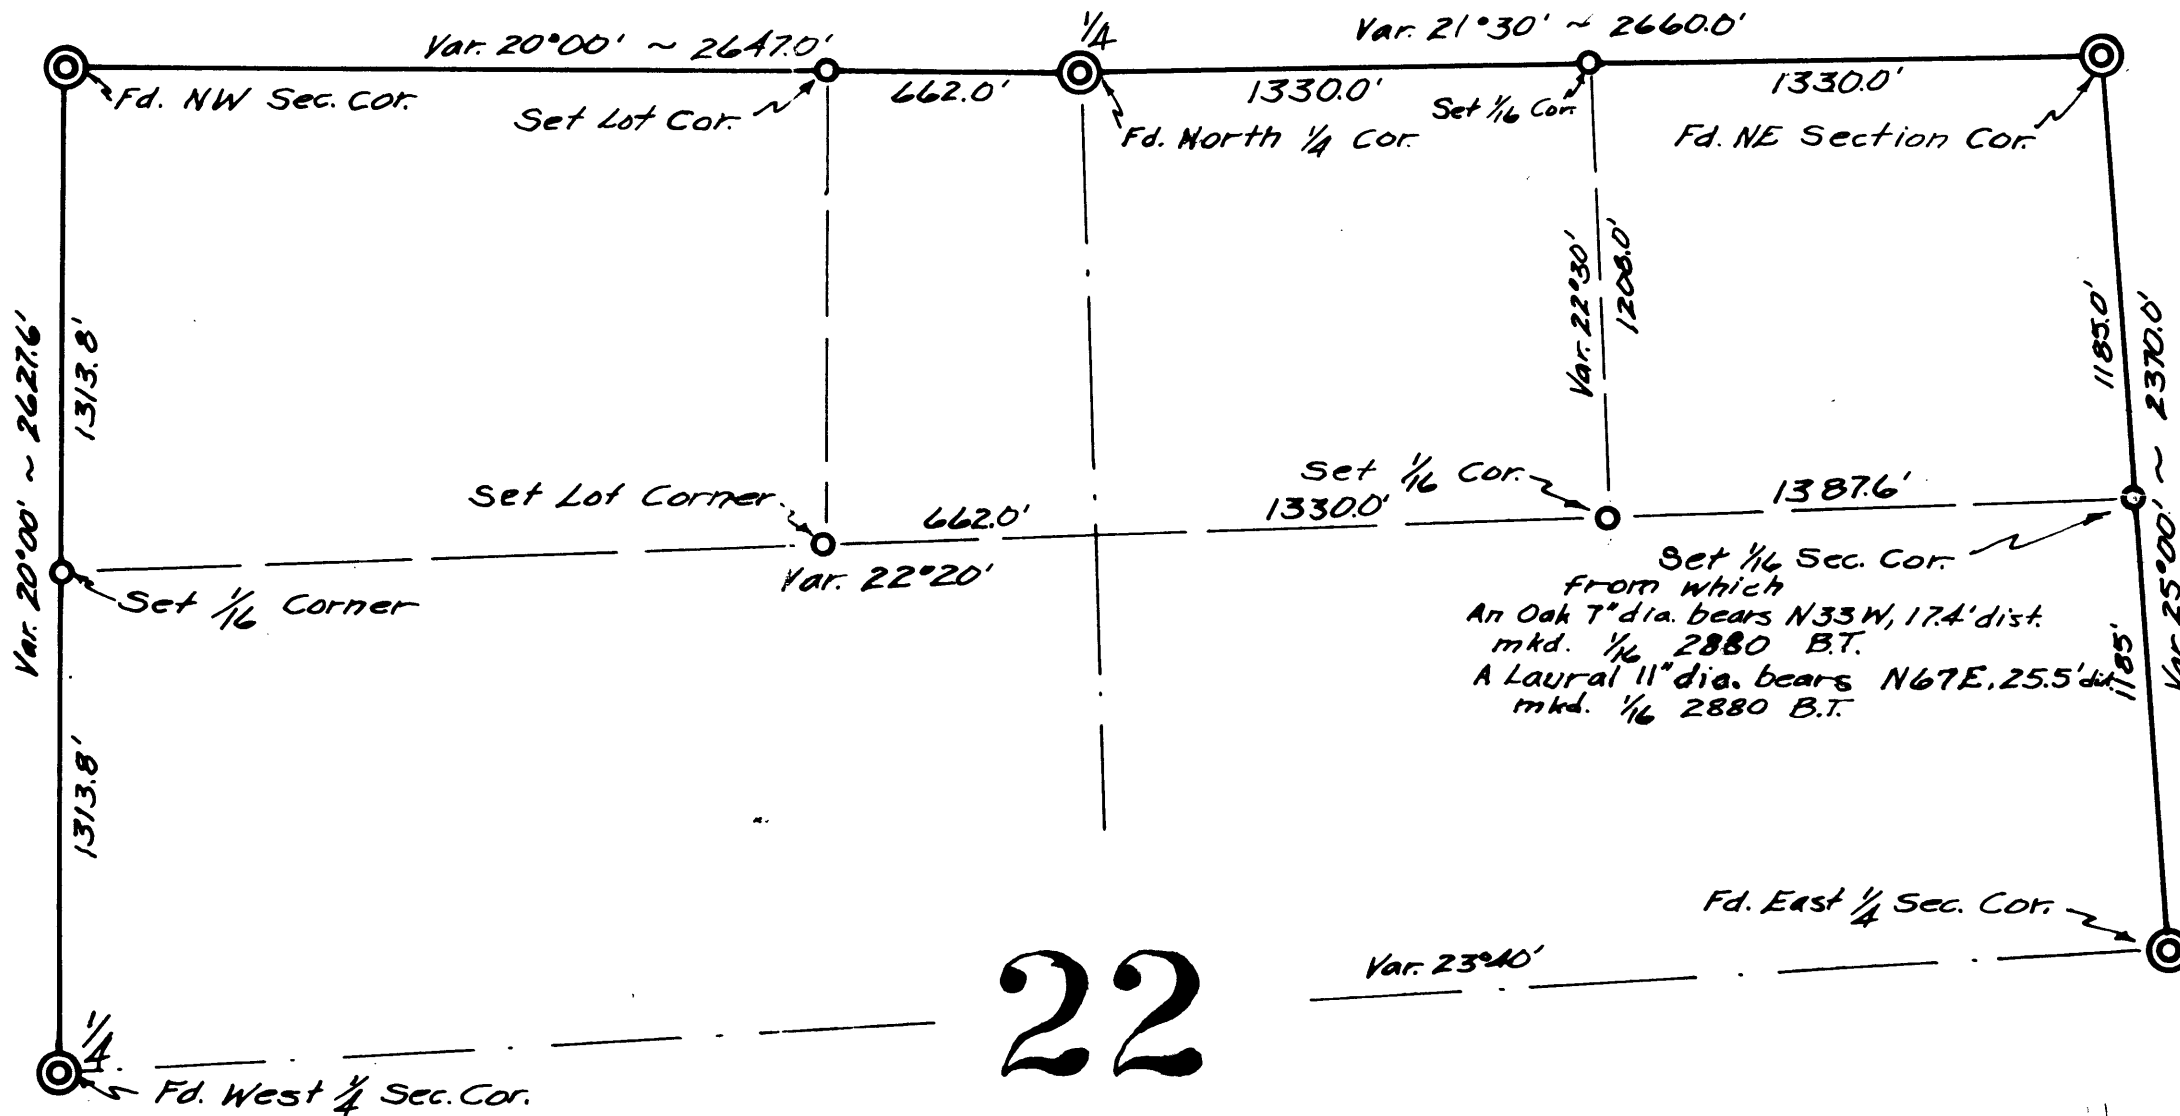

# 22

CS FILE FOLDER

CONTAINS

MORE

INFORMATION