


#45
 S 52° W 10.9 chns
 S 77° 30' W 16.75 " on No Boundary CI #45
 West 4.00 "
 N 66° 45' W 5.5 " to Meander Post Between 20229
 (at 3.25 chns Intersect Meander Post Between 20229)
 West 20.7 chns to NW Corner

#44
 S 63° 30' W 15.0 chns
 West 5.0 "
 N 61° W 4.45 "
 N 43° 45' W 5.22 "
 N 84° 15' W 15.07
 S 59° 00' W 2.91
 S 53° W 20.0
 S 43° 45' W 22.00 chns to NW Corner CI #44

T 22 S R 8 W

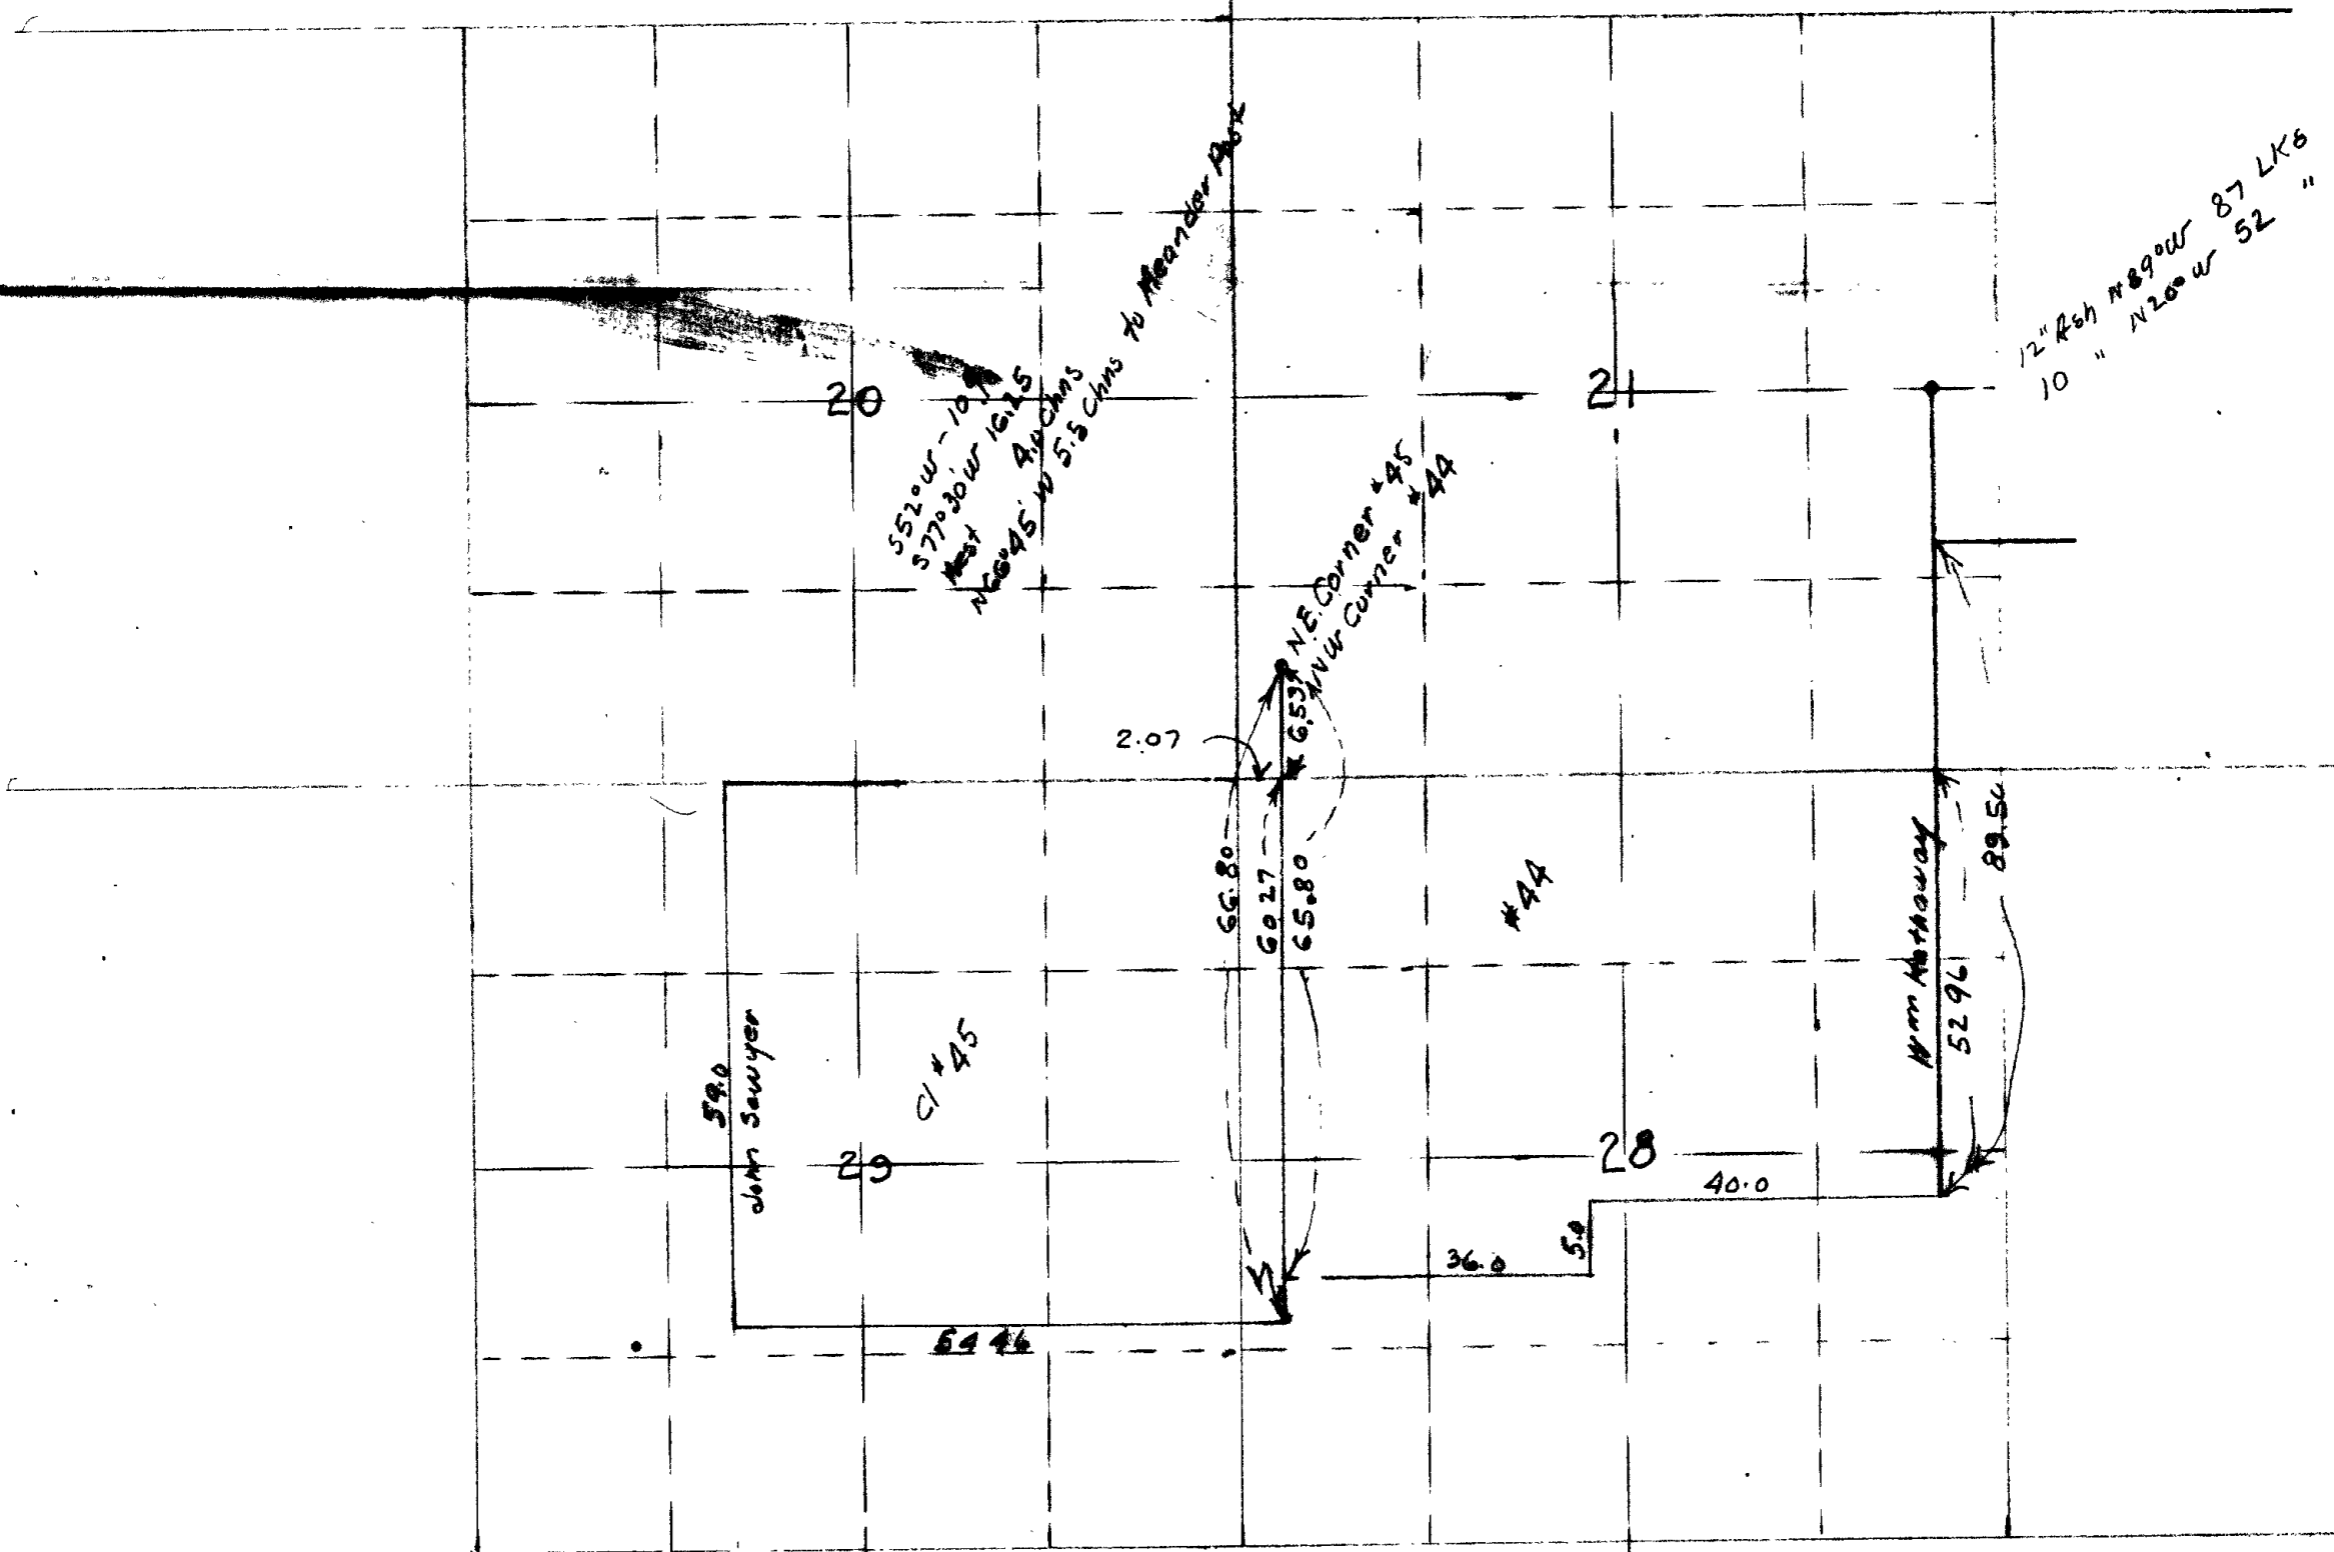

12" Rsh N 89° W 87 LKs
 10 " N 20° W 52 "