

PREPARED FOR

DELBERT SHELTON


PORTION SECTIONS 22 & 27 T28S R4W W.M.

SCALE 1" = 600'

JULY 1949

**COUNTY SURVEYORS FILE DATA
DO NOT REMOVE FROM OFFICE**

Sec. 22

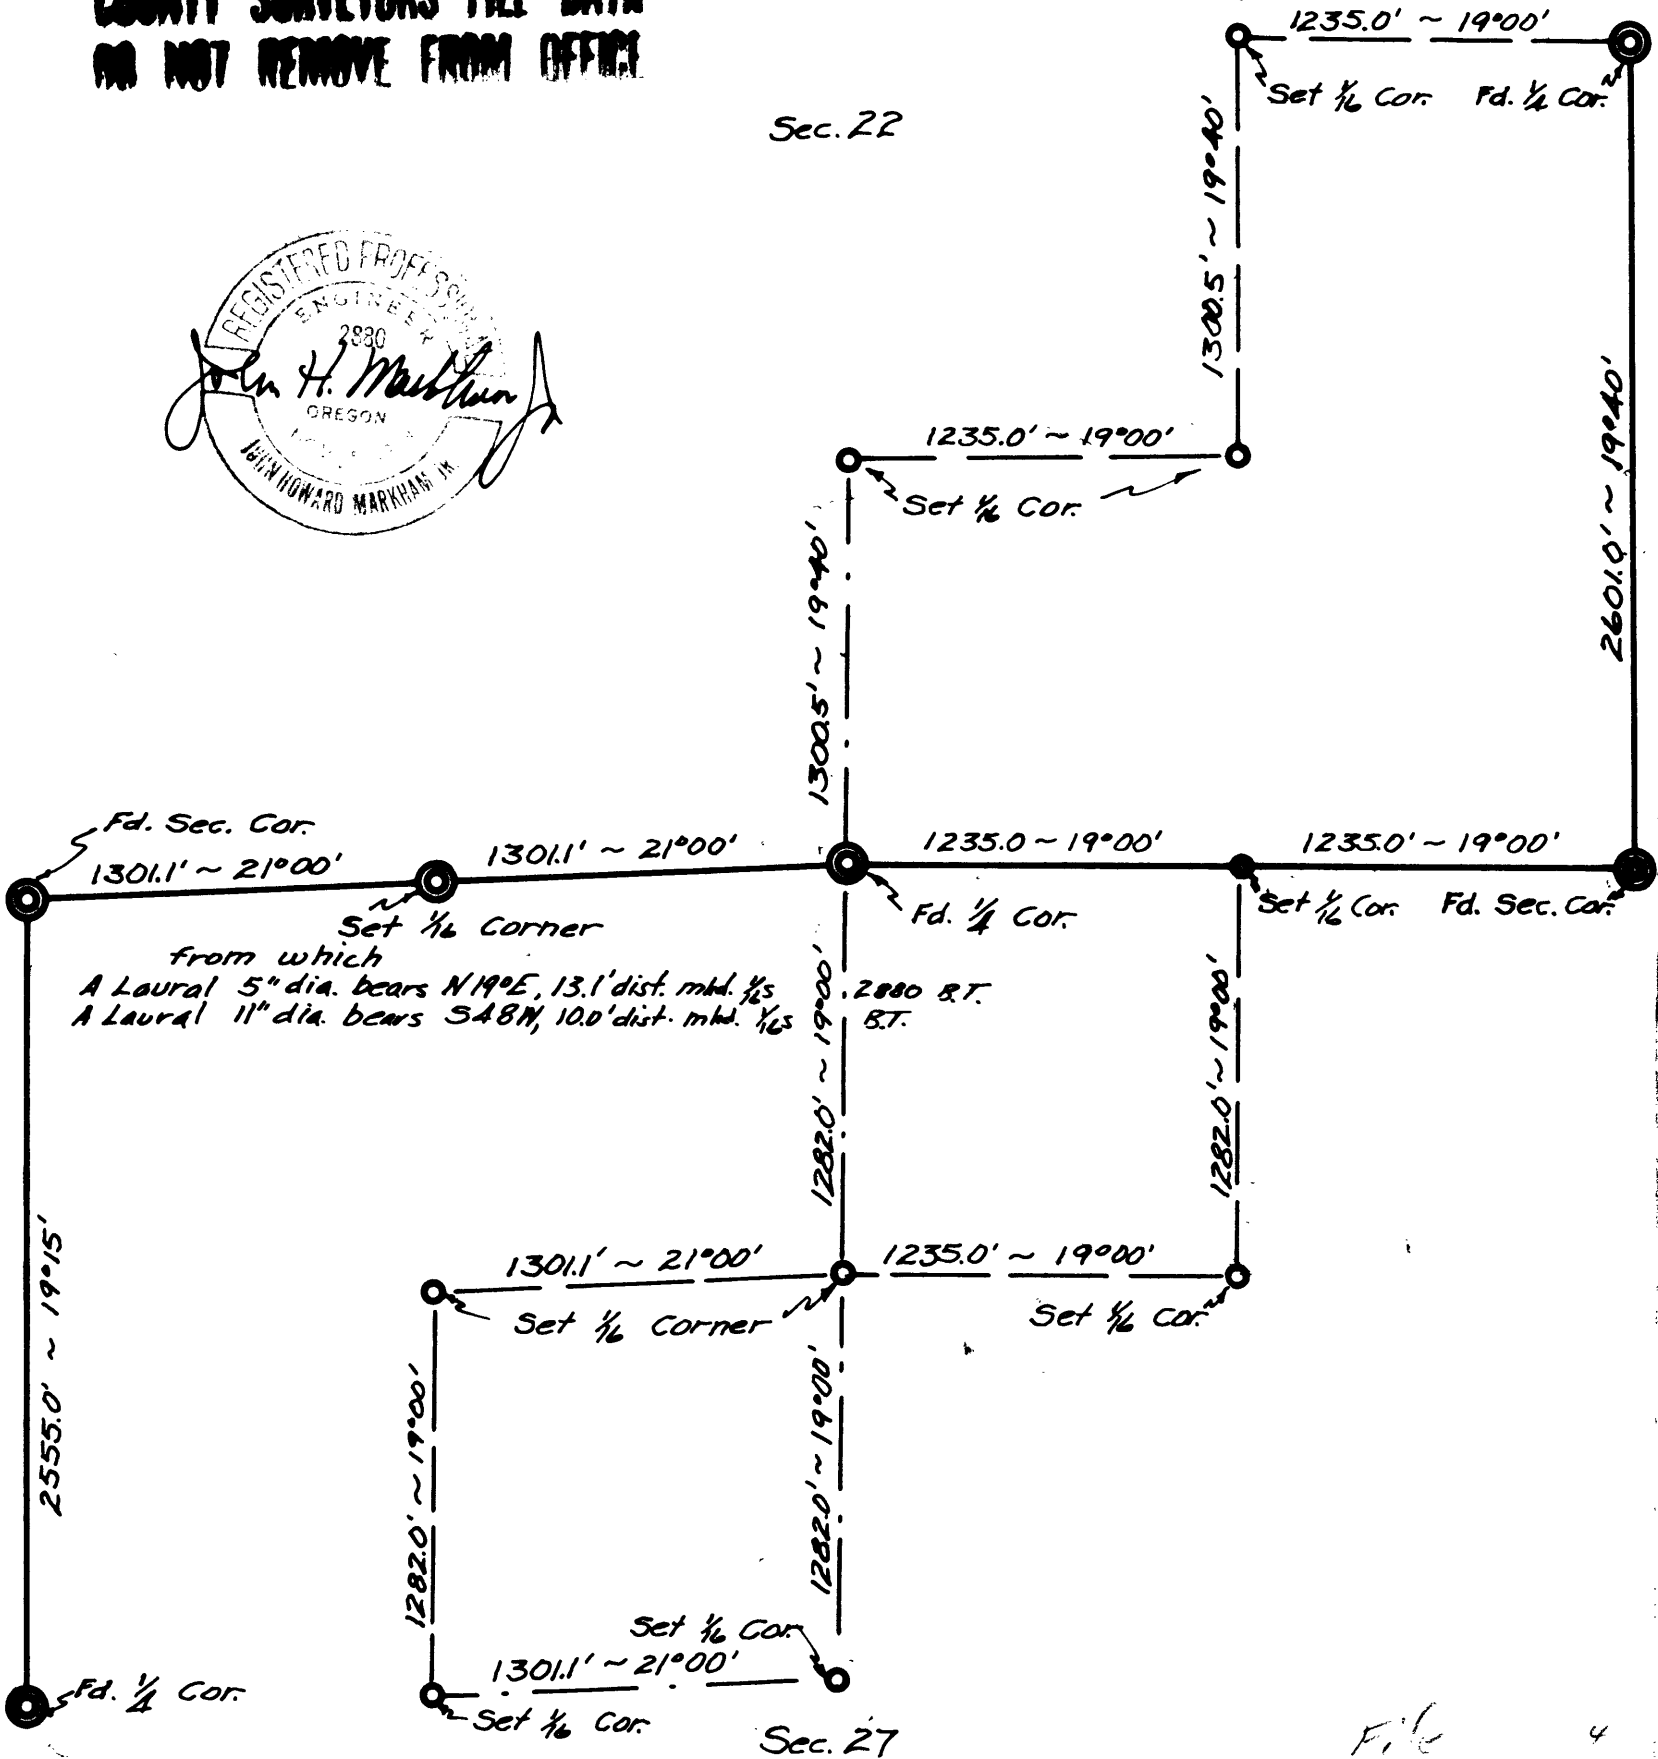

Sec. 27