
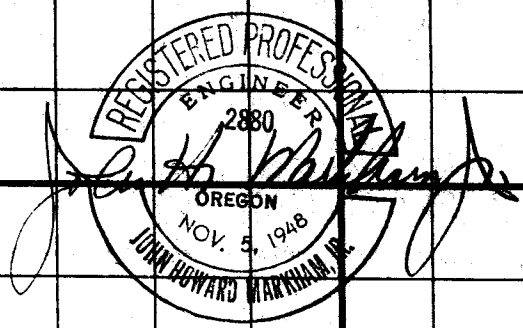


10-20-49

Town 30S Range 6W
Section 36 County Do.

JOHN MARKHAM, Forest Engineer

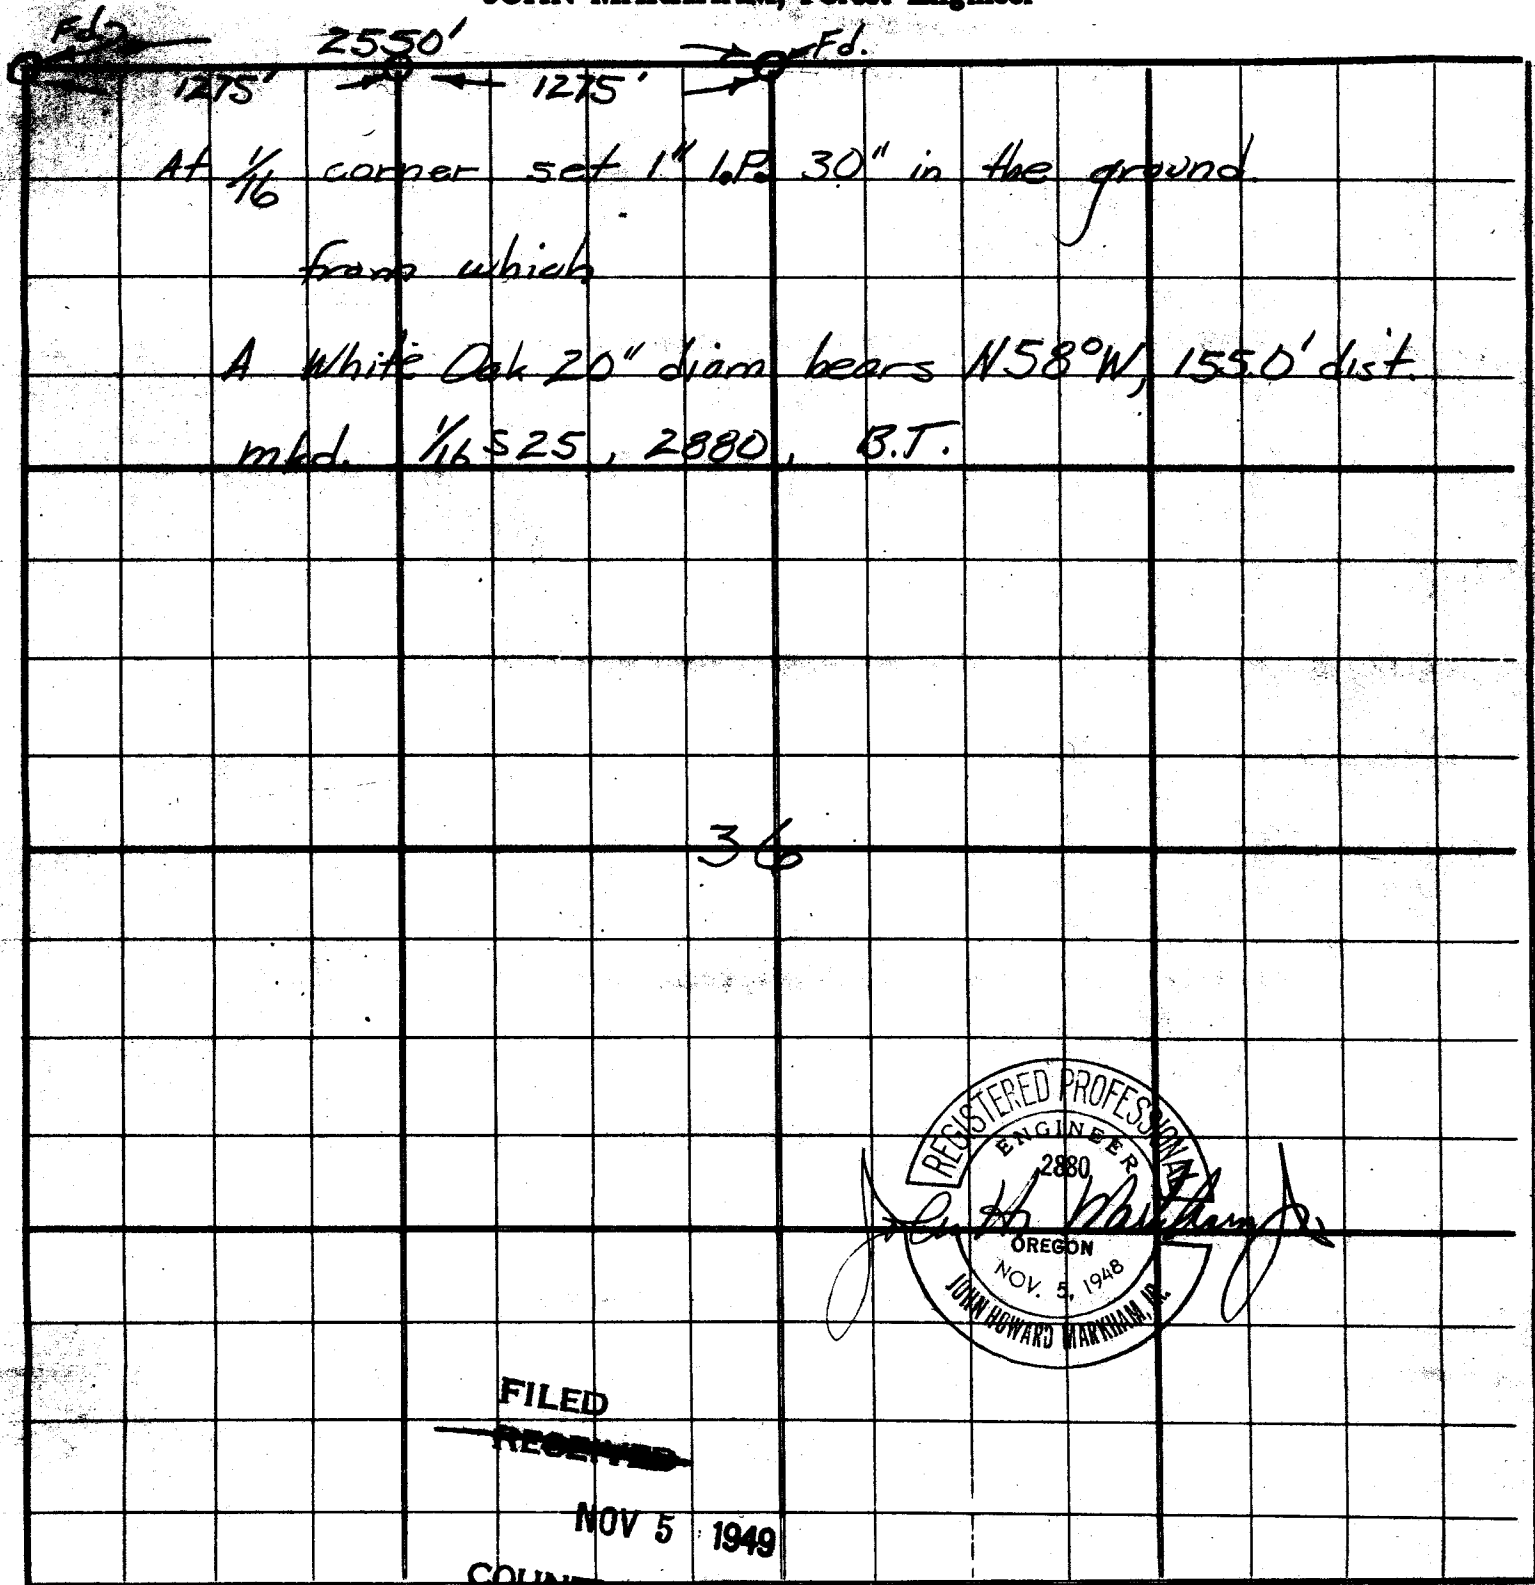

FILED
~~RECEIVED~~
 NOV 5 1949

COUNTY SURVEYOR
 DOUGLAS COUNTY, ORE.

EXAMINED

10/188-1