

10-20-49

T305 R6W

1/4 Section Corner 25 + 36  
as determined from <sup>probable</sup> ~~original~~ B.T.


An Oak stump bears East, 30.0'

At corner pt. set wood stake  
from which

A ca. 7" diam. bears North 29.0' dist.  
mkd. S25, 1/4S 2880 B.T.

A ca. 6" diam. bears S33E, 23.0' dist.  
mkd. S36, 1/4S, 2880, B.T.

There is a fence running West +  
South from this corner; it being  
470' West to E shoe string road.

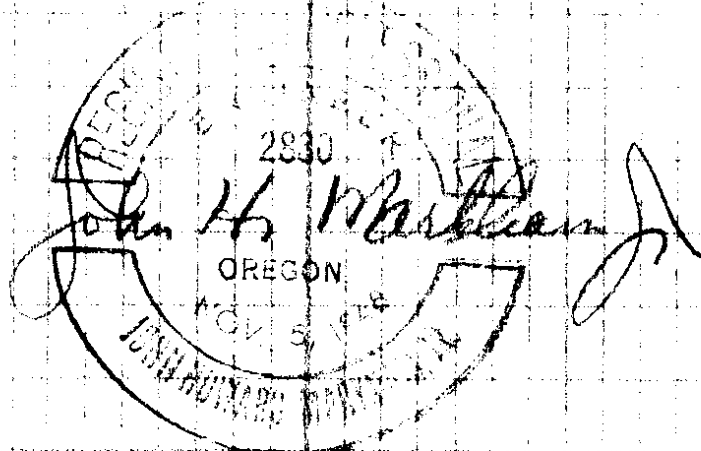

40/188-2