

10-20-49

T 305 - R 6W

The Section Corner 25, 26, 35+36 as determined from the original B.T.'s.

An oak stump bears N89W, 17.8' dist., scribe ledgable.

A B.O. S42E, 58' dist.; this original B.T. I rescribe S36 2880 B.T.

A W.O. S58W, 49 1/2', with scar.


At corner point fd. 2 wooden stakes. From which

A La. 12" diam. bears N23E, 85' dist. mkd. S25 2880 B.T.

A Fir 12" diam. bears N24W, 45' dist. mkd. S26 2880 B.T.

A La. 7" diam. bears S64W, 9.5' dist. mkd. S35 2880 B.T.

This cor. being centered perfectly on top of main ridge. There is a fence running N+S from cor. the gate being 60' North of cor.

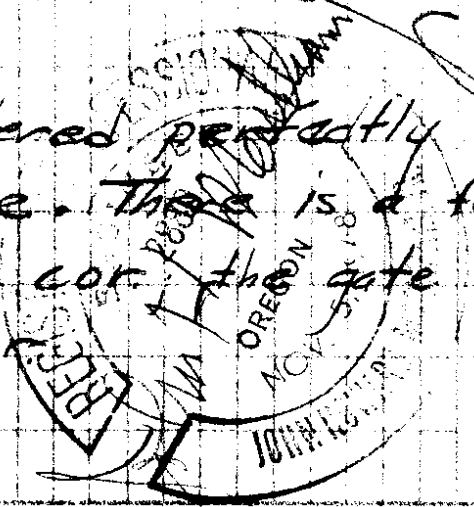

40/88-3