


COUNTY SURVEYORS FILE DATA
DO NOT REMOVE FROM OFFICE

PREPARED FOR

E. J. PUDDICOMBE

PORTION OF SEC. 20, T 30S, R 5 W


SCALE 1"=200' APRIL 1949

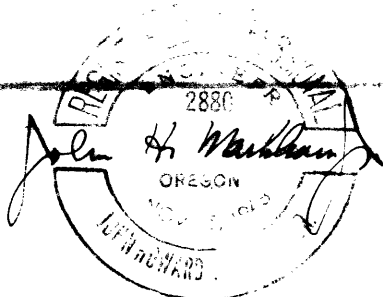

At N.W. Cor. of Cl. #44 I set 1" I.P., 40" long.
from which

A Fir, 5" diam, bears S66W-8.5' mkd. Cl. #44, 2880 B.T.

A Fir, 19" diam, bears S78E-33.5' mkd. Cl. #44, 2880 B.T.

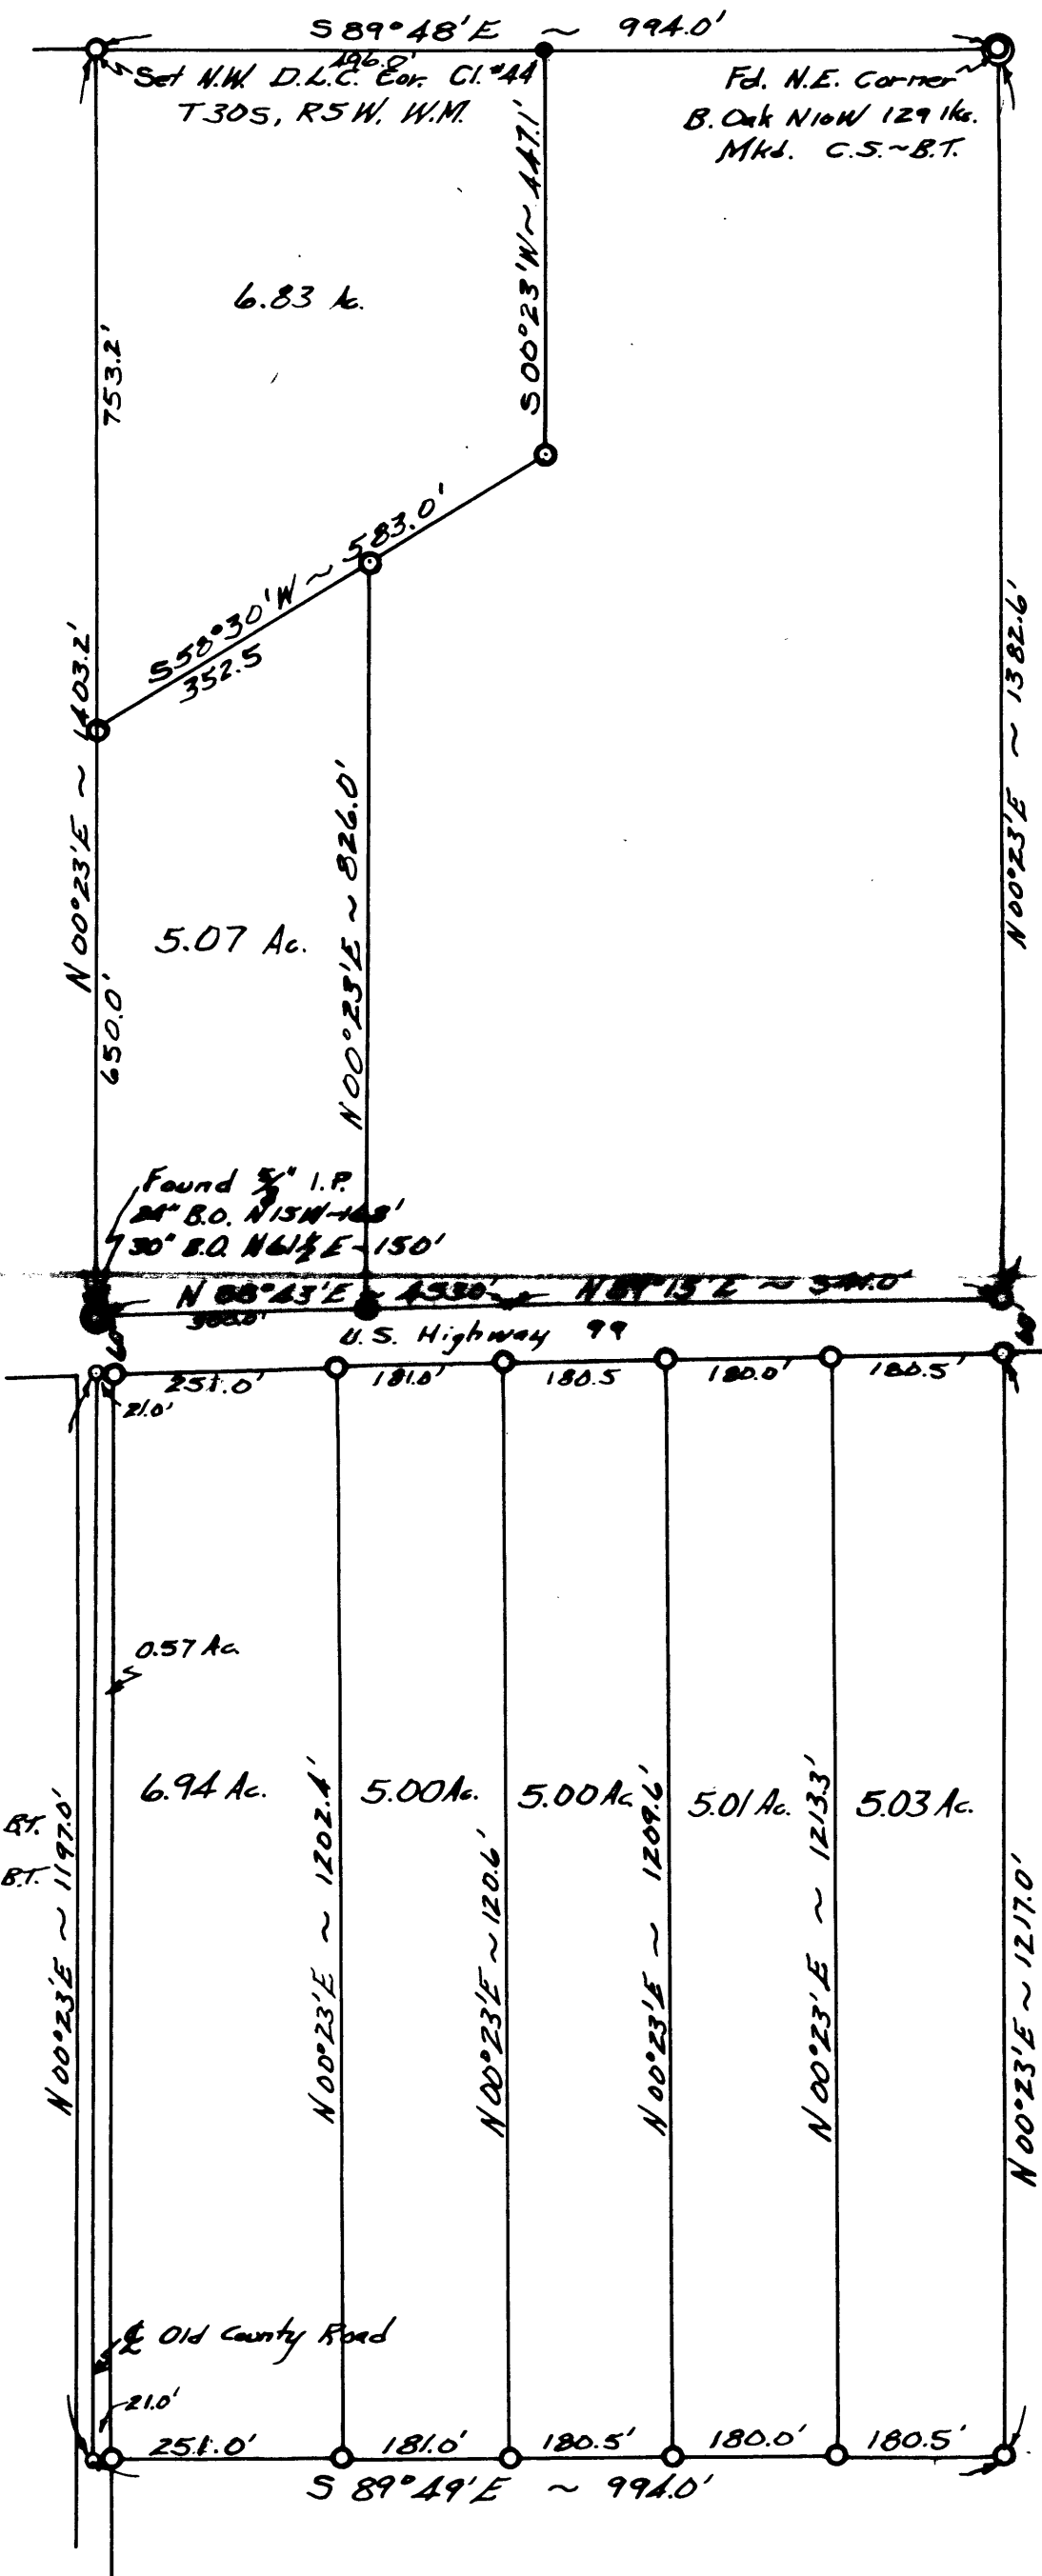

File

CS FILE FOLDER

CONTAINS

MORE

INFORMATION