

H. W. LAWRENCE
REGISTERED ENGINEER
MINE SURVEYS A SPECIALTY
WOLF CREEK, ORE.
P. O. BOX 110-105

June 6, 1949

County Surveyor.,
Douglas County,
Roseburg, Oregon.

Dear Sir;

On May 16, 1949; your office gave me the following information, for the S. E. Cor. of the NE $\frac{1}{4}$ of the NW $\frac{1}{4}$ of Sec. 26, T.32 S.; R. 5 W.


A fir 30" dia. bears S. 38° E. at 21.78'

A 6" laurel bears N. 18°- 27' E. at 5.49'

At this point, on May 17, 1949; I drove,

A $\frac{3}{4}$ " iron pipe 36" long, 30" into the ground.

Yours truly,

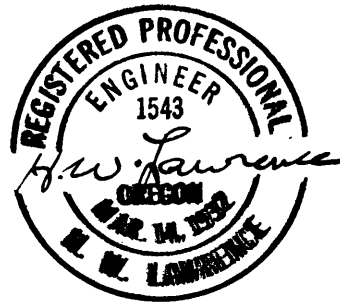

c.s. 40/191