

T285 R5W. W.M.

Corner Sections 25, 26, 35, 36

The section corner was determined from the remains of an original B.T.

A dead Ash laying on the ground bears $N45^{\circ}E$, 70.0' dist; the old scribe is very plain.

At the corner point.

Set an Iron Post, 30" long, $\frac{3}{4}$ " diam. 24" in the ground.

from which:


A Fir 10" diam bears $S38^{\circ}E$, 33' dist.
mhd. S 36 2880 B.T.

A. B. Oak, 18" diam. bears $S23W$, 50' dist.
mhd. S 35 2880 B.T.

A Cedar 15" diam. bears $N37W$, 3.0' dist.
mhd. S 26 2880 B.T.

A Fir, 11" diam. bears $N73E$, 18' dist.
mhd. S 25 2880 B.T.

9-21-49

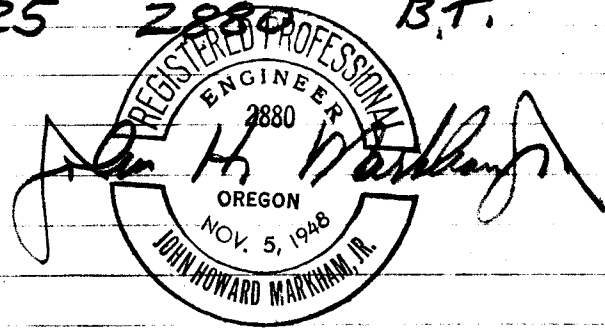

c.s. 40/206