

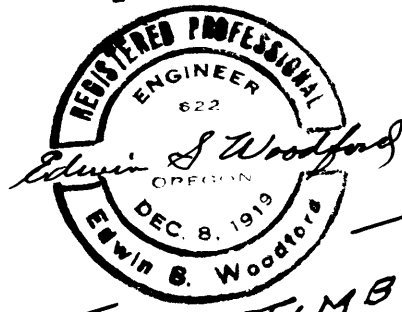


MAP
OF
South Portion of Lots-13 & 14 PLAT A
SUTHERLIN LAND & WATER Co.
Sec. 15-TP.25S-RG.5W WM.
Oct. 1949. Scale-1"=100.

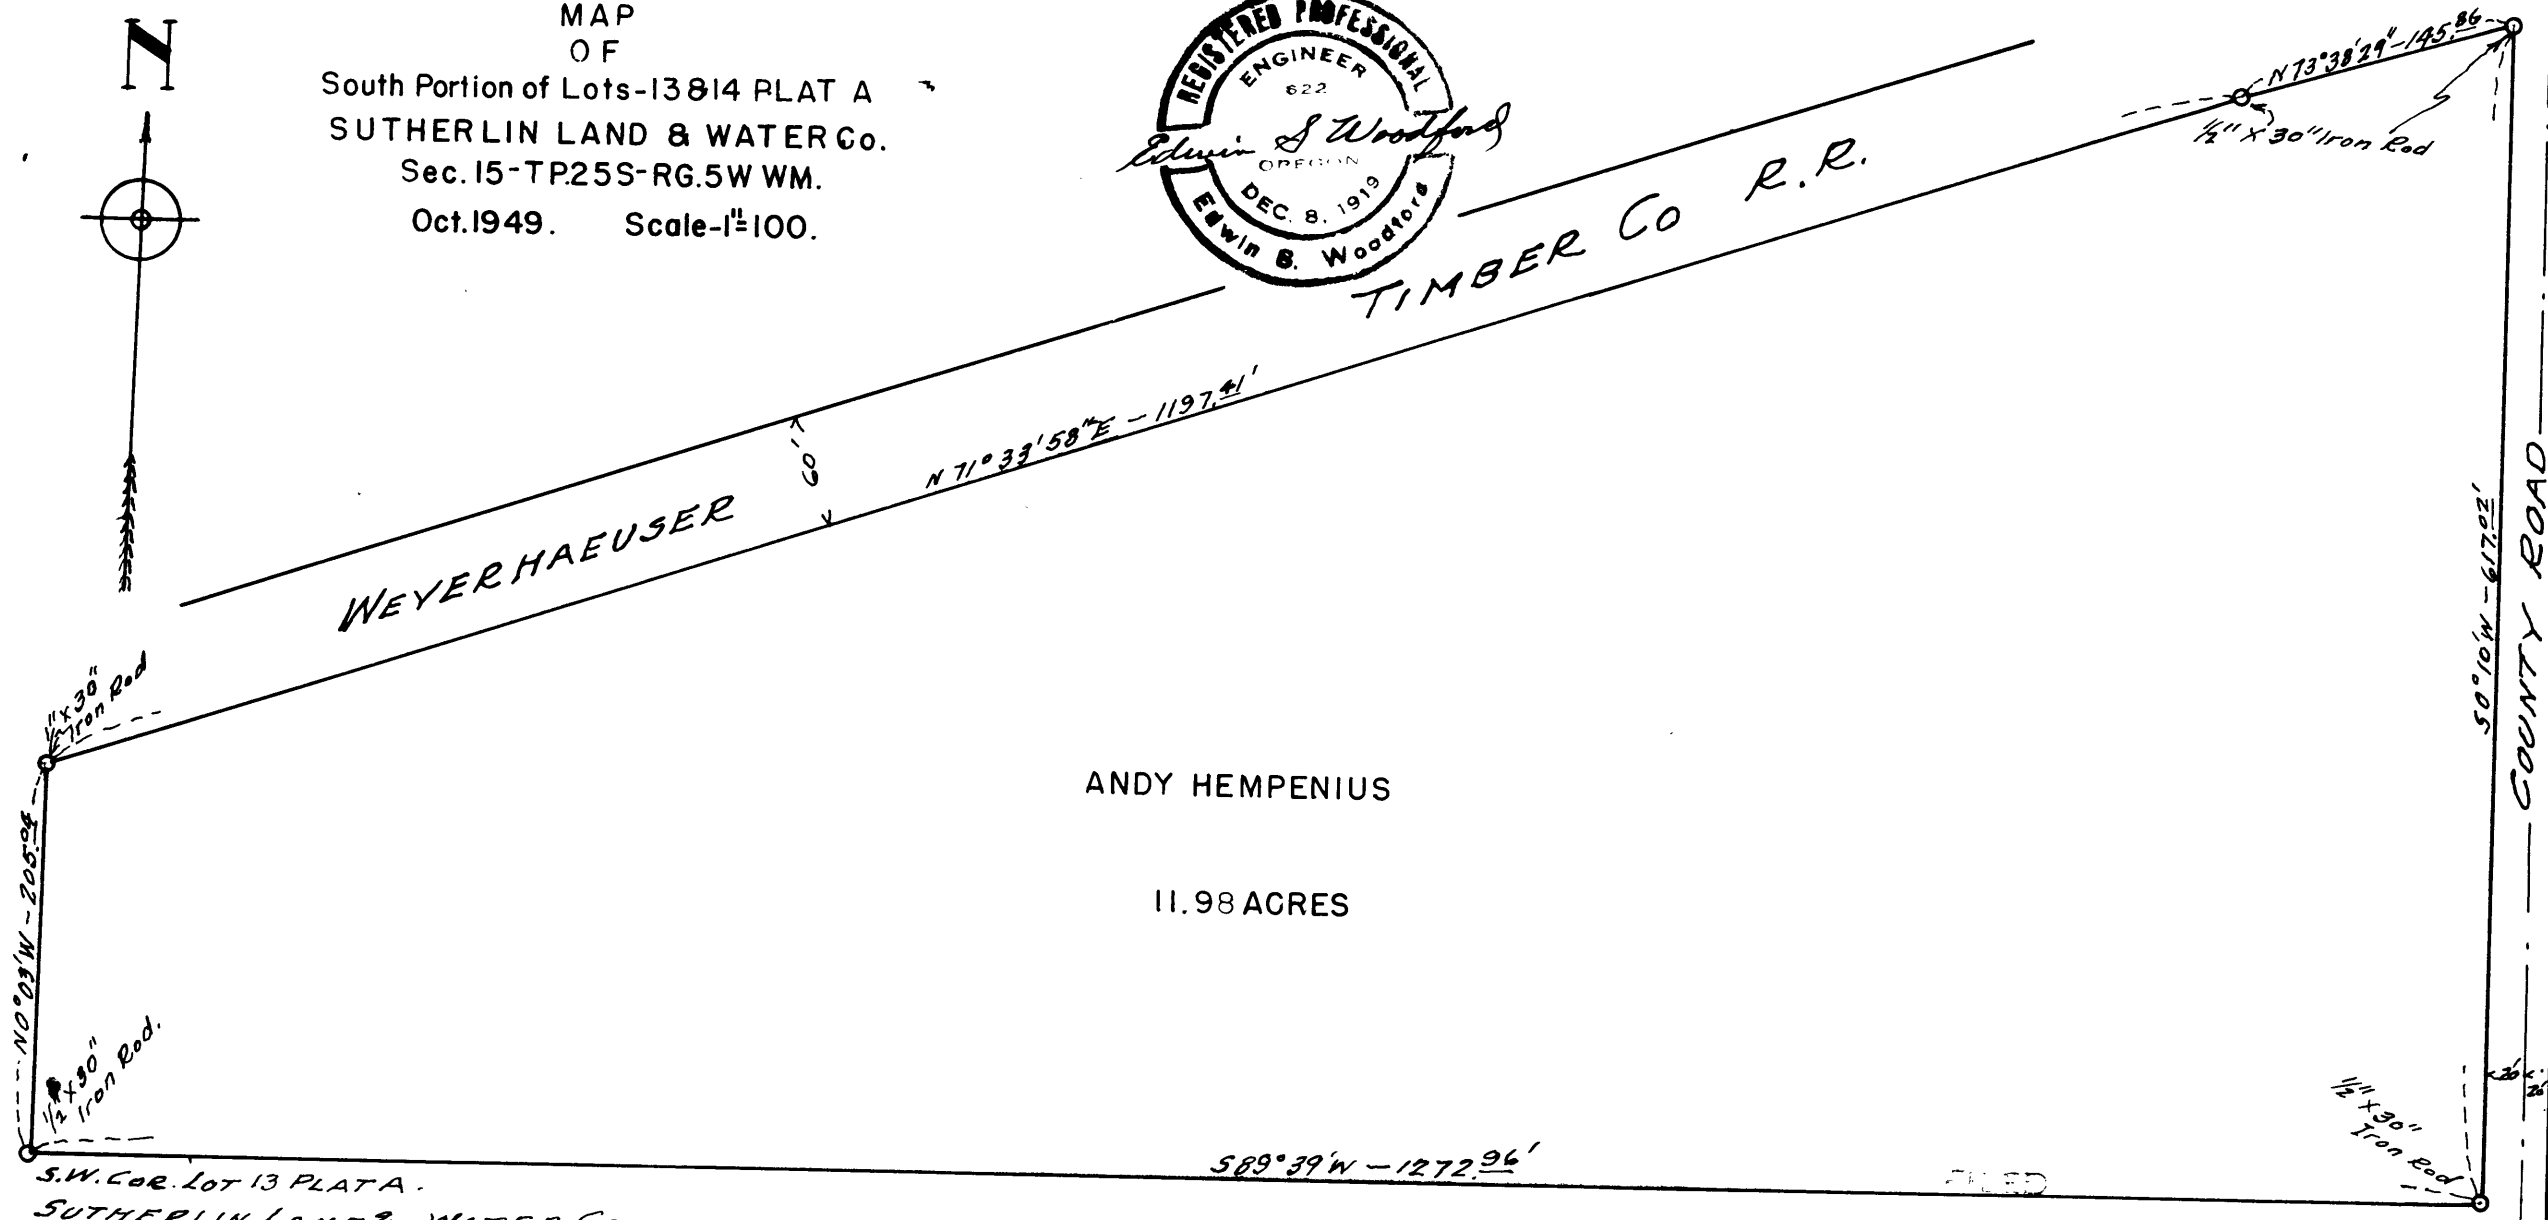

TIMBER CO R.R.

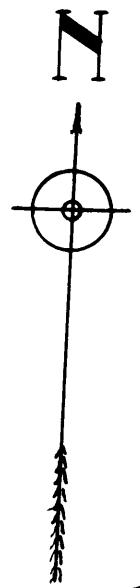

COUNTY SURVEYORS FILE DATA
DO NOT REMOVE FROM OFFICE

FILED
RECEIVED
JUN 1949
COUNTY SURVEYOR
CLATSOP COUNTY OREGON

CS FILE FOLDER

CONTAINS

MORE

INFORMATION