

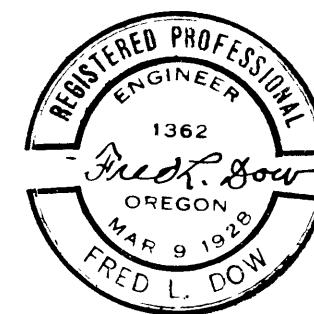


COUNTY SURVEYORS FILE DATA
DO NOT REMOVE FROM OFFICE

SURVEY FOR DEED DESCRIPTION
IN CITY OF DRAIN, ORE
NOV. 1 1949
SCALE 1"=40'

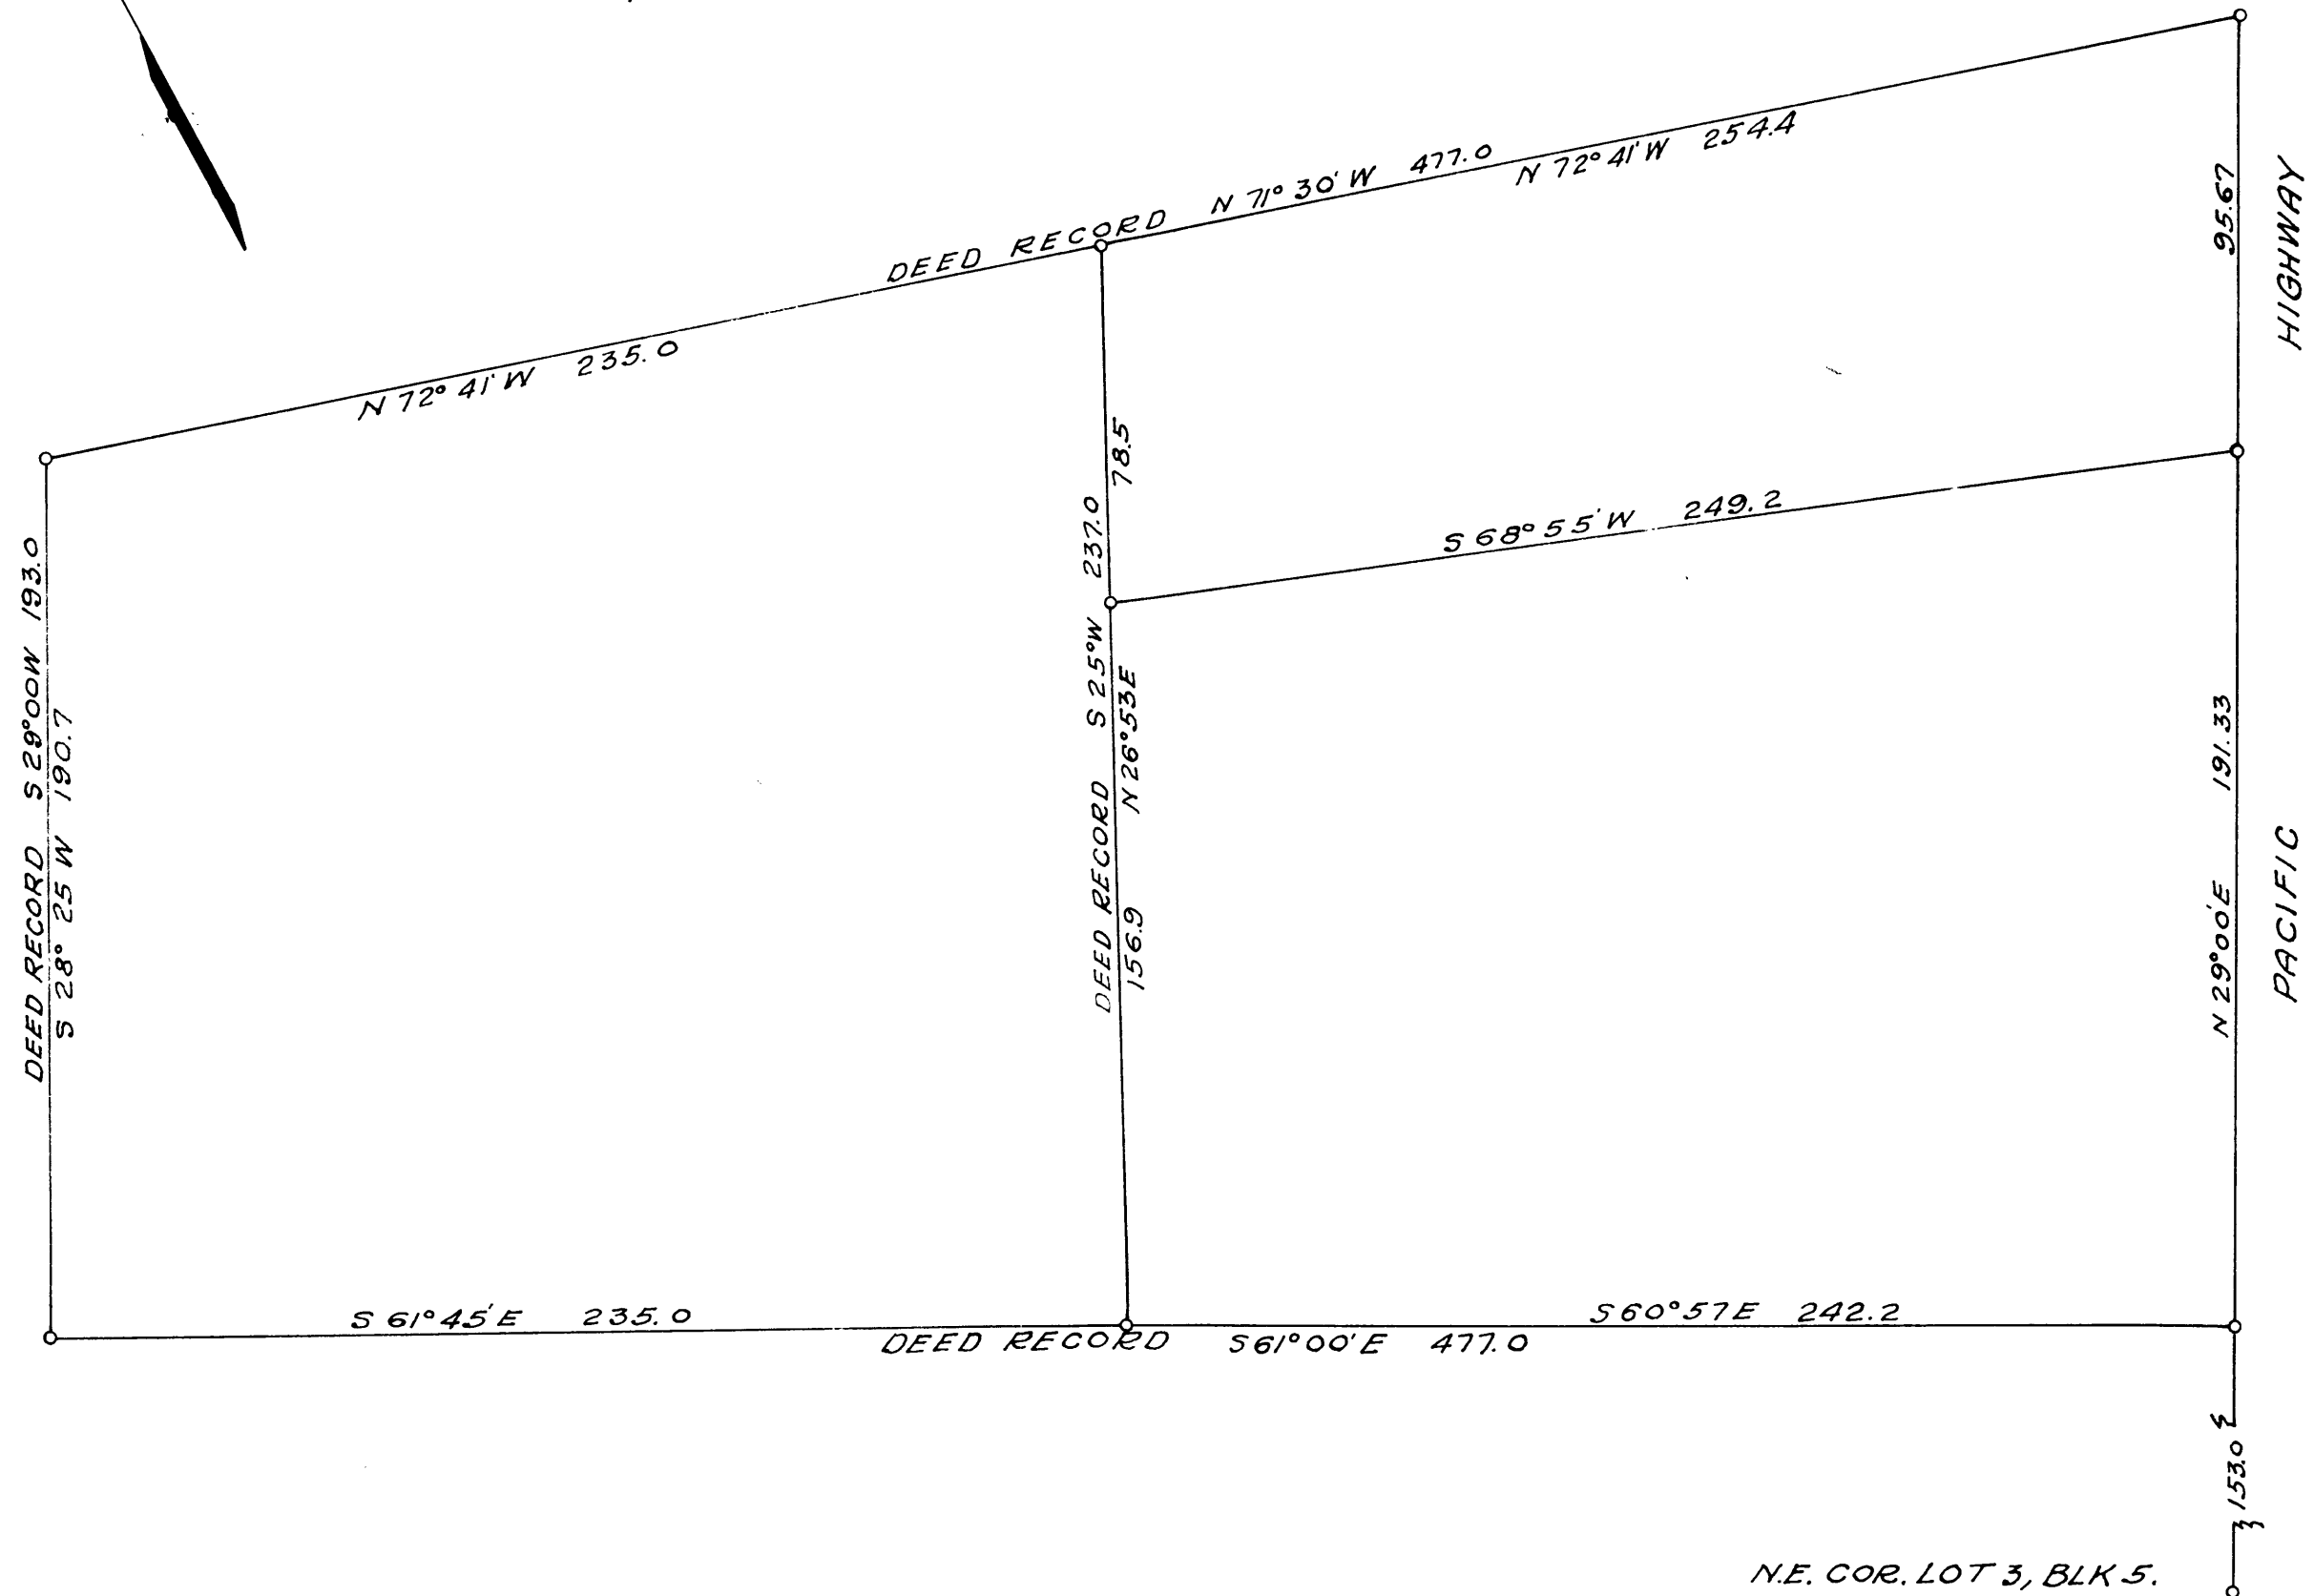

NOTE:-
BEARINGS SHOWN ARE
BASED ON ϕ S.P.R.Y. N29°E

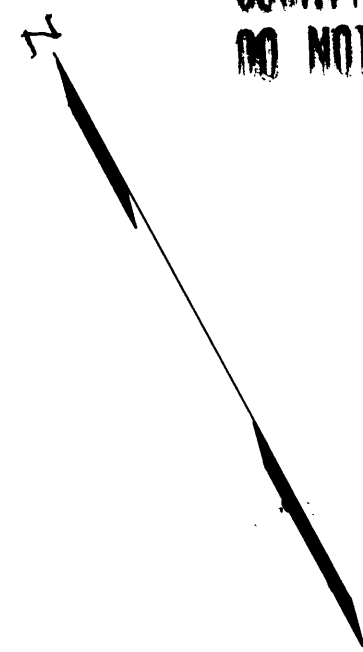

N.E. COR. LOT 3, BLK 5.
KREWSONS ADDITION
TO THE TOWN OF DRAIN