

T 30S - R 5W

The Sec. Cor. 28-29-32-33 as determined
from remains of original B.T.

A B.O. 23" diam East 7.3' dist.
which I rescribe S 33 - 2880 - B.T.

A W.O. 27" diam bears S 55 W,
49.5' dist which I rescribe


S 32 - 2880 - B.T.

A stump hole N 55 W 34.0' dist.
At corner point fd. pile of rock
and drove a $\frac{3}{4}$ " x 24" I.P. 20"
in ground.

From which

A W.O. 14" diam bears N 68 W,
107.0' dist. mkd. S 29 - 2880 - B.T.

There is a fence running N+S from
this cor. The road is 141.0'
south of ~~the~~ corner.

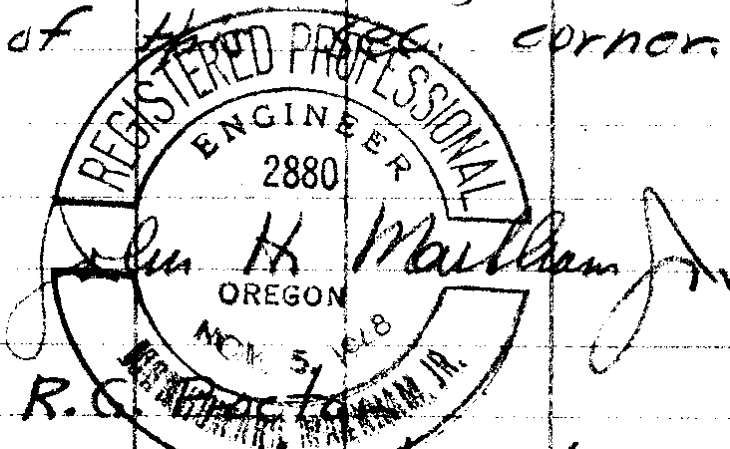

Witness: R.C. [unclear]
Geo. Bollenbaugh.

11-11-49
c.s. 40/213