

T30S - R5W

The $\frac{1}{4}$ section corner Sec.
28 + 33, as determined from
remains of the original B.T.s.

A. W.O. stump S25E, 60.0'
dist. scribe still legdable.


At corner point set $\frac{1}{2}$ " x 24" I.P. 18"
in ground.

from which

A Fir 17" diam. bears N80E
175' dist. mkd. $\frac{1}{4}$ S S28
2880 B.T.

A La. 11" diam bears S51W, 98.0'
dist mkd $\frac{1}{4}$ S S33-2880 - B.T.

The fence corner is 16.2' South
of $\frac{1}{4}$ cor. These are fences
running -W from this cor.

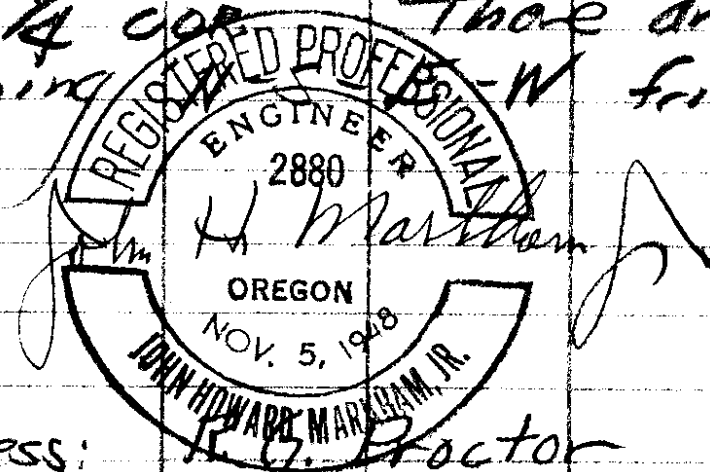

Witness: J. H. Proctor

11-11-49

CS. 40/213 2