



27

FOUND
6" W.O.
EPPSTEIN
1927

8" W.O. 1949 Blaze 28" up
N 7° 36' W 12.7'
12.7' N 4° W

FOUND
18" W.O.
ORIGINAL SURVEY
1853

Tie-in Thennes Grove Plat N22°52'E
40.9' ±
N 33° E
Azimuth held to blaze 4'-0" up 24" W.O.
N 39° E 40.55' 1979

IRON PIN SET (5/8" x 24")

13.9'
S 46° 30' W
10" W.O. Blaze 30" up
S 71° 41' W 13.9'

FOUND
8" W.O.
EPPSTEIN 1927

34

188.76'
S 72° E


24" W.O.
ORIGINAL SURVEY
1853
(NOT FOUND)

1/4 CORNER LOCATION
BETWEEN SECT. 27 & 34
T.26 S., R.6 W., WM.

JAMES R. DAUGHERTY
CIVIL-SANITARY ENGINEER
REGISTERED PROFESSIONAL
ENGINEER
ROSEBURG OREGON

DATE: 7/10/79

SCALE: 1" = 4'

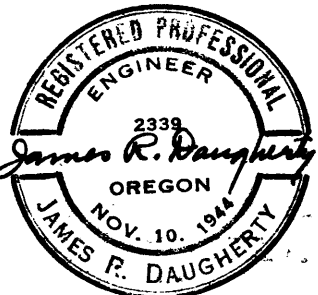

COUNTY SURVEYORS FILE DATA
DO NOT REMOVE FROM OFFICE

Jeano

CS FILE FOLDER

CONTAINS

MORE

INFORMATION