

COUNTY SURVEYORS FILE DATA
DO NOT REMOVE FROM OFFICE

REGISTERED
OREGON
LAND SURVEYOR

O. F. Thiel

MARCH 10, 1944
OSCAR F. THIEL
4

FILED
RECEIVED

MAR 9 1950

COUNTY SURVEYOR
DESSAS COUNTY, ORE.

T 2 S, R 6 W, Sec. 17

Number _____

WILLIAM BRAGG.


Sect. 7 TP. 22 S. R. 6 W.

Beginning at a point a galvanized iron pipe
1 1/2 inch by 30 inches long which bears North 30 de-
grees East 483.02 feet of the Southwest corner of
Claim No. 37 (Joseph Daisley) in Township 22 South
Range 6 West and a witness corner which bears North
30 degrees East 97.02 feet which is an iron bar 1/4
inch by 1 1/4 inch firmly set in the ground and a
Cedar post properly marked (C. S.) set along side
thence running North 30 degrees East 336 feet the
beginning point thence North 30 degrees East on the
Claim line 338 feet to the South side of Highway No.
38 right-of-way which is an iron rod 1 inch by 24 inches
long thence South 70 degrees and 02 minutes East a-
long the right-of-way 150 feet to a galvanized iron
pipe 1/2 inch by 30 inches long thence South 30 degrees
West 338 feet to an 1/2 inch by 28 inches long iron
pipe from which a White Fir 24 inches in diameter bears
South 10 degrees West 28 feet and marked S.R.S. No. 4
B.T. A Fir 28 inches in diameter bears North 27 degrees
East 24.7 feet and marked S.R.S. No. 4 B.T. thence
North 70 degrees and 02 minutes West 150 feet to be-
ginning point, and containing 75/100 of an acre.

~~FILED~~
RECEIVED

MAR 9 1950

COUNTY SURVEYOR
DOUGLAS COUNTY, ORE.

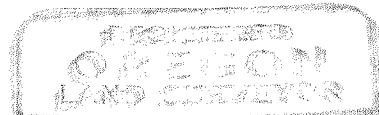

O. F. Thiel



c.s. 40/226