


July 15, 1949

Found badly rotted old stake in 1/4 Corner between Sections 19 and 20, T 26 S - R 3 W - W.M., Douglas County, Oregon. Drove 1" x 30" steel bar to perpetuate Corner.

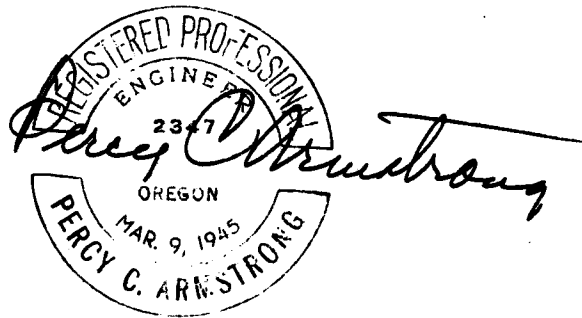

~~FILED~~  
RECEIVED

FEB 15 1950

COUNTY SURVEYOR  
DOUGLAS COUNTY, ORE.

Rec. 3-14-50  
C.L.F.

CS. 40/228