


COUNTY SURVEYORS FILE DATA  
DO NOT REMOVE FROM OFFICE

FILE 229 DRAWER 40  
229

J.F. WHITE

LOT 22, BLK 3, PLAT "D"  
SUTHERLIN LAND & WATER CO  
MAR. 1950  
SCALE 1"=200'

FRED L. DOW  
SURVEYOR

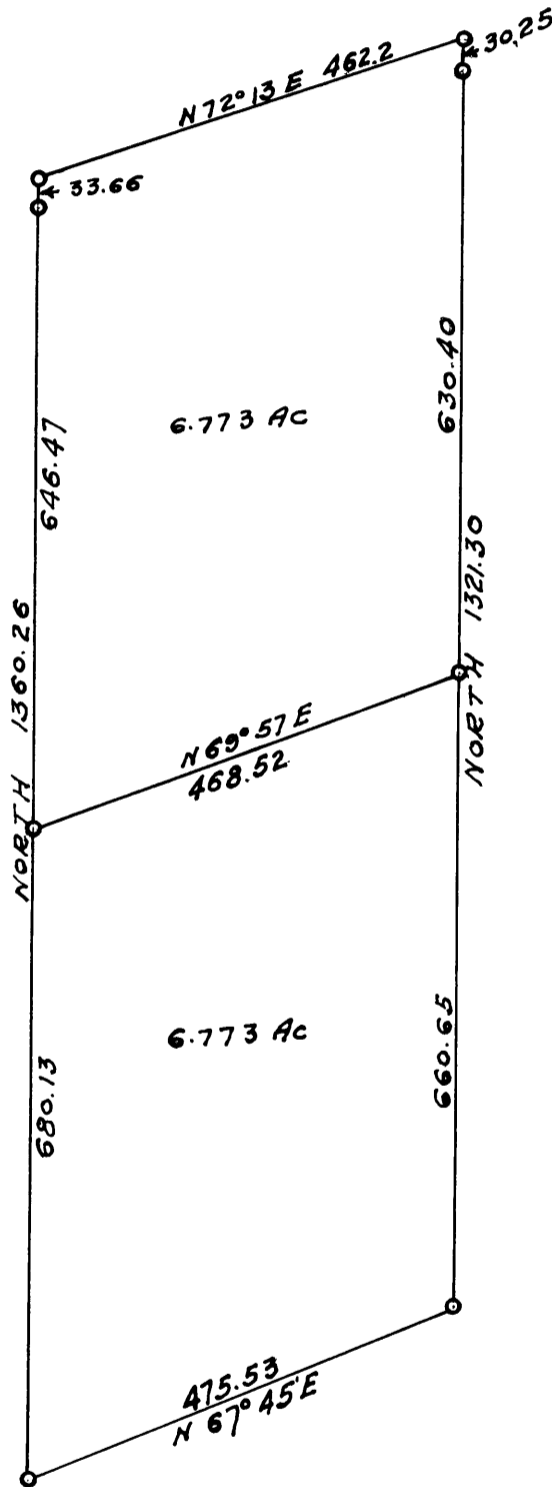

CS FILE FOLDER

CONTAINS

MORE

INFORMATION