

3-26-50

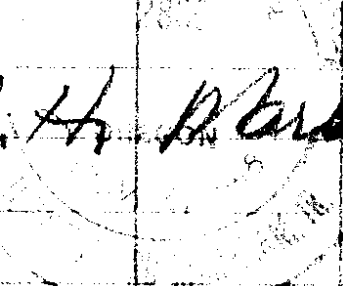
N.E. corner D.L.C. #48, T30S, R6W,
W.N. as determined from old B.T.'s.

● A B.O. 36" diam. bears S55°W,
46.2' dist; this old B.T. I rescribe
CL. 48 B.T.

● A W.O. 20" diam. bears N32°W,
39.0' dist; this old B.T. I rescribe
CL. 48, B.T.

● At corner point found $\frac{1}{4}$ " x 1"
iron bar I set a 1" x 30" I.P.
20" in ground

from which,
A B.O. 14" diam bears N2°E,
18.0' dist. mhd. CL. 48, 2880, BT


John H. Barblan

Recorded
A-18-50
CS 40

Witness:

S. B. Nickols

Geo. Vaughn

Work done for Stomar Lbr. Co.

CS 40/237