

12-5-49.

Section Corner 5, 6, 32 on the North Twp. Line T30S, RAW, as set by field notes.

At a pt. 650.0' West of South $\frac{1}{4}$ cor Sec. 32 on Twp. Line, I set a $\frac{3}{4}$ " x 24" I.P. 14" in the ground.

From which

A Fir 23" diam. bears N10W, $19\frac{1}{2}$ ' dist. mkd. S32, 2880, B.T.

A La. 4" diam. bears S25W, 40.0' dist. mkd. S6, 2880 B.T.


A La. 3" diam. bears S58E, 34.0' dist. mkd. S5, 2880 B.T.

A diligent search was made for original B.T.s, but no evidence was found.

Witness:

W^m Markham

Received
12-5-50

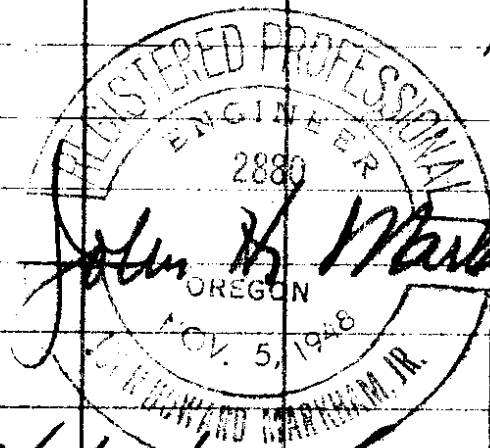

John H. Markham

Work done for Markham & Son Lbr. Co.

CS 40/239-1

over.

In checking the notes I
found the $\frac{1}{4}$ cor. was
reestablished from 1 B.T.
I used the intersection
of both original B.T.'s
& all of the calls checked
(including bearings)
John H. Workman

FILED
RECEIVED

DEC 7 1949

COUNTY SURVEYOR
DOUGLAS COUNTY, ORE.