

1/16 cor. Sec 6, T305, RAW on Twp.
 Line. At a pt. 1320.0' West
 of Sec. cor. 5, 6, 32 and 654.0'
 East of Sec. Cor. 6, 31, 32 I
 set a 3/4" x 24" I.P. 14" in ground.


From which

A 10" diam. bears N4E, 20.0'
 dist. mkd. 1/16 56 2880 B.T.

A Fir 6" diam. bears S84W, 12 1/2'
 dist. mkd. 1/16 56 2880 B.T.

Witness:

Wm Markham

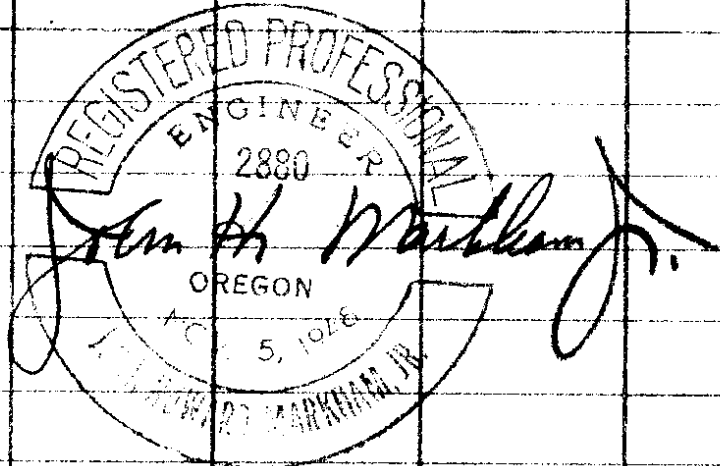

Work done for Markham & Sons Lbr. Co.