

2-15-51

¼ Section Corner 28-29, T30S  
R5W, W1N as determined by  
renewed field notes.

At corner point fd stone  
+ drove 1" x 2" I.P.

Both O.B.T. dead, one down.

from which

A Fir 16" diam. bears N13E,  
5.0' dist. mkd. ¼ S, B.T.


A Fir 8" diam. bears N40W, 36.0'  
dist. mkd. ¼ S 29, B.T.

Creek bears No. 150' dist.

There is a fence running  
No. + East from this corner.

Witness:

Wm E. Markham

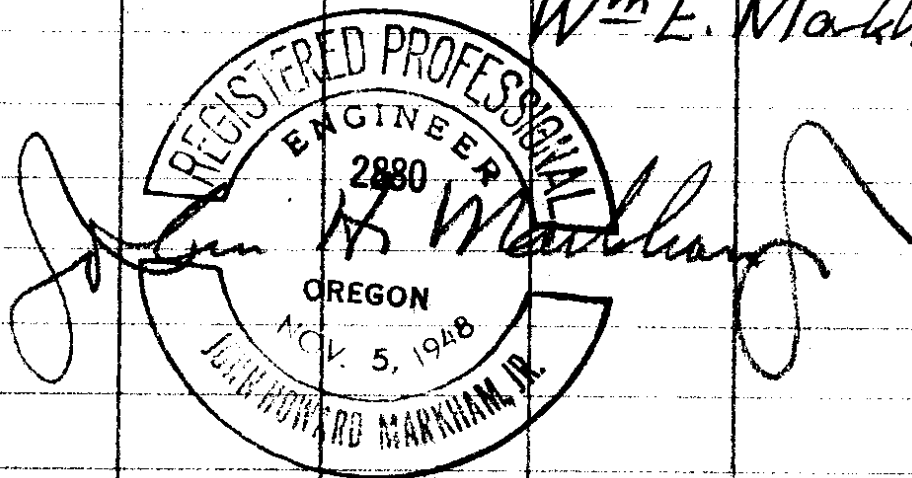

CS 40/250A-3