

4-22-51

N.W. Cor Section 2, T30S,  
R5W. W.M.

At cor. pt. drove 1x30"  
Truck axle in original  
stone monument,  
from which


A Fir 5" diam. bears S87°E  
23.2' dist. wkd. S2, T30S,  
R5W. B.T.

An Oak 6" diam. bears  
S29°W, 18.7' dist. wkd.  
S3, 2880, B.T.

S.E. Cor. Sec. 34 bears West  
355.0' dist.

Witness:

Bill & Geo. Vaughn

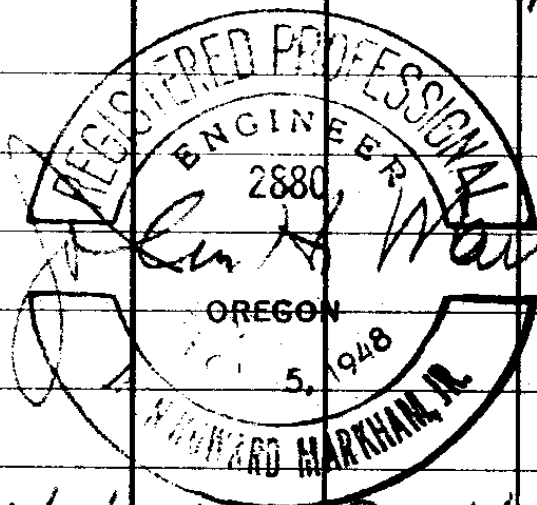

Work done for Hauslander Lbr. Co.

40/250A-7