

Survey for Ivan Harris.

Sec. 28, T. 20. S. R. 6. W.

Begin at the one-quarter sec. corner on the south line of sec. 28 where I found a post from which a Fir 24" brs. N. 27° 30' E. 52.0 feet. Blaze had been opened several years ago but shows no marks. A Fir 24" brs. S. 73° W. 37.3 feet. Did not open. Found no trace of the Orig. B.T. a Laurel 8"

Fred Prella took us to this corner and said he was present when it was restored in 1936 in Survey for White.

Run East by traverse to the south east corner of section 28 where I found the B.T. described as a 60" Fir stub S. 72° 00' W 13.2 feet. Marks rotted away. Fred Prella saw scribe marks on this 16 years ago. Orig Fir 3" now 24" brs. S. 76° E. 13.9 feet, remarked B.T. Set a 5/8" iron rod and marked new a Fir 8" S. 1° 00' W. 17.8 feet. B.T. Fir 6" N. 65° W. 13.6 feet. B.T.


Run thence West on true line, at 1303.87 feet by proportionate measurement set a 5/8" iron rod for the 1/16th corner from which a Fir 24" brs. S. 75° 30' E. 18.0 feet. B.T. Fir 24" brs. S. 4° 00' W. 30.6 feet. B.T.

Begin again at the south east corner of section 28 and run North on old blazed line. At 2640.0 feet find no trace of one-quarter Cor.

Go back to south one-quarter of section 28 and run North 1320.0 feet. Set post marked 20 chains No. of one-quarter corner. Found old post about 60.0 feet north and 60.0 feet west.



Chas. C. Hayden

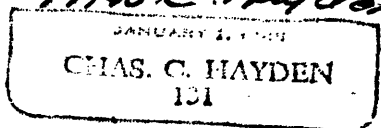

File 255 Drawer 90

**COUNTY SURVEYORS FILE DATA
DO NOT REMOVE FROM OFFICE**

June 1950

THOMSON & HAYDEN
SURVEYORS
3RD FLOOR - COURT HOUSE
PH. 4-7652 EUGENE, OREGON