

6-21-50

Section 15-16-21-22, T28S, R4W,
W.M. as determined from remains
of original B.T.

A dead Cedar wind fall
S88W, 26.0' dist. Scribe legible.


A white N15W, 16.0' dist,
I remark S15.

A 30" White Fir S38E, 21.0'
dist, I remark S22

At corner pt. set $\frac{3}{4}$ " x 30"
I.P. 20" in ground
from which

A Cedar 4" diam. bears N72E
9.5' dist. mkd. S15, 2880, B.T.

A Cedar 12" diam. bears S83W
41.0' dist. mkd. S21, 2880, B.T.

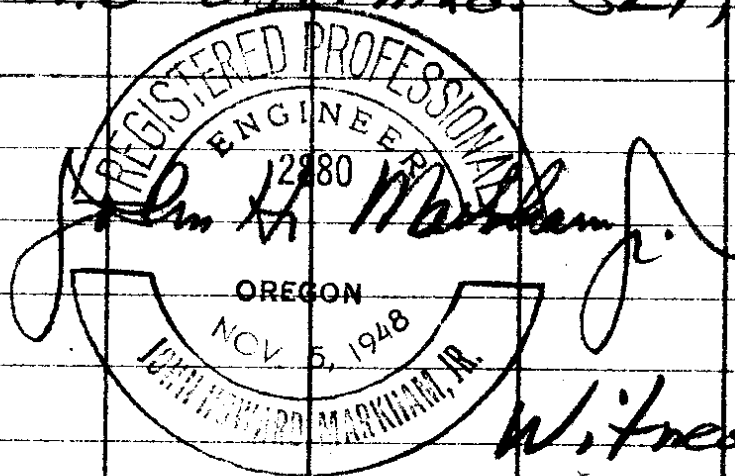

Witness

Geo. Vaughn

Bill Vaughn

CS 49/257-2